

STATE CORPORATION COMMISSION OF KANSAS
OIL & GAS CONSERVATION DIVISION
WELL COMPLETION OR RECOMPLETION FORM
ACO-1 WELL HISTORY

DESCRIPTION OF WELL AND LEASE

Operator: license # 6086
name The Production Team
address P. O. Box 785
Independence,
City/State/Zip Kansas 67301

Operator Contact Person Alexander Davie
Phone 1-331-2835

Contractor: license # 5493
name Pat Chase-Chase Drilling

Wellsite Geologist None
Phone N/A

PURCHASER Eureka Crude

Designate Type of Completion
 New Well Re-Entry Workover

Oil SWD Temp Abd
 Gas Inj Delayed Comp.
 Dry Other (Core, Water Supply etc.)

If OWWO: old well info as follows:
Operator N/A
Well Name
Comp. Date Old Total Depth

WELL HISTORY

Drilling Method: Mud Rotary Air Rotary Cable
12/14/89 12/15/83 8/15/84
Spud Date Date Reached TD Completion Date

179
Total Depth PBD

Amount of Surface Pipe Set and Cemented at 20 feet

Multiple Stage Cementing Collar Used? Yes No

If Yes, Show Depth Set feet

If alternate 2 completion, cement circulated
from 0 feet depth to 20 w/ 8 SX cmt

API NO. 15-037-20, 999
County Crawford
NE/4 (location) Sec 4 Twp 28 Rge 23

3890 Ft North from Southeast Corner of Section
1730 Ft West from Southeast Corner of Section
(Note: locate well in section plat below)


Lease Name Pearson Well# 14

Field Name ? Farlington

Producing Formation Peru

Elevation: Ground ? KB -

Section Plat

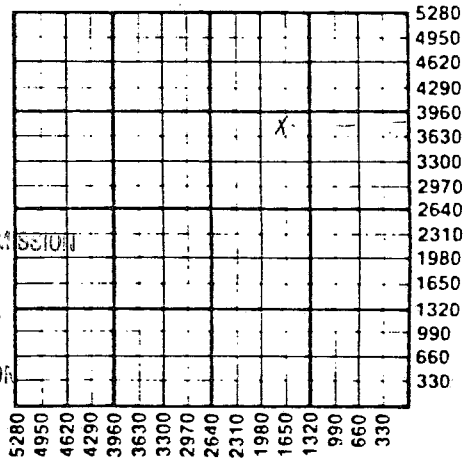

RECEIVED
DEC 07 1984
STATE CORPORATION COMMISSION
CONSERVATION DIVISION
Wichita, Kansas

WATER SUPPLY INFORMATION

Source of Water:
Division of Water Resources Permit # N/A

Groundwater... Ft North From Southeast Corner of (Well) ... Ft. West From Southeast Corner
Sec Twp Rge East West

Surface Water... Ft North From Southeast Corner of (Stream, Pond etc.) ... Ft West From Southeast Corner
Sec Twp Rge East West

Other (explain) (purchased from city, R.W.D.#)

Disposition of Produced Water: Disposal Repressuring

Docket # N/A

INSTRUCTIONS: This form shall be completed in duplicate and filed with the Kansas Corporation Commission, 200 Colorado Derby Building Wichita, Kansas 67202, within 90 days after completion or recompletion of any well. Rules 82-3-130 and 82-3-107 apply.

Information on side two of this form will be held confidential for a period of 12 months if requested in writing and submitted with the form. See rule 82-3-107 for confidentiality in excess of 12 months.

One copy of all wireline logs and drillers time log shall be attached with this form. Submit CP-4 form with all plugged wells. Submit CP-111 form with all temporarily abandoned wells.

All requirements of the statutes, rules, and regulations promulgated to regulate the oil and gas industry have been fully complied with and the statements herein are complete and correct to the best of my knowledge.

Signature Sam Wiseman
Title Agent Date 10/25/84

Subscribed and sworn to before me this 25 day of Oct. 19 84

Notary Public Priscilla P. Davies PRISCILLA P. DAVIES
Date Commission Expires 10/8/88 Notary Public STATE OF KANSAS

K.C.C. OFFICE USE ONLY
F Letter of Confidentiality Attached
C Wireline Log Received
C Drillers Timelog Received
Distribution
 KCC SWD/Rep NGPA
 KGS Plug Other (Specify)

Sec. 4 Twp. 28 Rge. 23

Operator Name The Prod. Team Lease Name Pearson Well# 14 SEC 4 TWP. 28 RGE. 23 East West

WELL LOG

INSTRUCTIONS: Show important tops and base of formations penetrated. Detail all cores. Report all drill stem tests giving interval tested, time tool open and closed, flowing and shut-in pressures, whether shut-in pressure reached static level, hydrostatic pressures, bottom hole temperature, fluid recovery, and flow rates if gas to surface during test. Attach extra sheet if more space is needed. Attach copy of log.

Drill Stem Tests Taken Yes No
 Samples Sent to Geological Survey Yes No
 Cores Taken Yes No

Formation Description
 Log Sample

Name Top Bottom

DRILLERS LOG ONLY

Approx.

0-8	Clay
8-13	Limestone
13-85	Sand & Shale
85-140	Shale & Limestone
140-TD	Sand & Shale-TD

CASING RECORD <input checked="" type="checkbox"/> new <input type="checkbox"/> used							
Report all strings set - conductor, surface, intermediate, production, etc.							
Purpose of string	size hole drilled	size casing set (in O.D.)	weight lbs/ft.	setting depth	type of cement	# sacks used	type and percent additives
Production Surface		2 7/8 6 5/8		approx. 20' " " 200'	Portland Portland	8 25	
PERFORATION RECORD				Acid, Fracture, Shot, Cement Squeeze Record			
shots per foot	specify footage of each interval perforated			(amount and kind of material used)			Depth
	No			Sand & Rock Salt			Approx. 180-197
OPEN HOLE				Liner Run <input type="checkbox"/> Yes <input checked="" type="checkbox"/> No			
Date of First Production	Producing method <input type="checkbox"/> flowing <input checked="" type="checkbox"/> pumping <input type="checkbox"/> gas lift <input type="checkbox"/> Other (explain)						
Estimated Production Per 24 Hours	Oil	Gas	Water	Gas-Oil Ratio	Gravity		
	Approx. 2 bbls. Bbls	0 MCF	20% Bbls	0 CFPB	32-34		

Disposition of gas: vented sold used on lease

METHOD OF COMPLETION open hole perforation other (specify)

PRODUCTION INTERVAL Dually Completed. Commingled