

CARD MUST BE TYPED

State of Kansas
NOTICE OF INTENTION TO DRILL
HUGOTON INFILL

RECEIVED
KANSAS CORPORATION COMMISSION
CARD MUST BE SIGNED
MAY 12 2004

EFFECTIVE DATE 6-27-04

Starting Date 6-27-04
month day year

API Number 15 - 055-21840-0080
CONSERVATION DIVISION
WICHITA, KS

OPERATOR: License # 33094 ✓
Name Cimarex Energy Co.
Address 15 E. 5th., Ste 1000
City/State/Zip Tulsa, OK 74103
Contact Person Michelle Farrell
Phone 918-585-1100

IS SECTION REGULAR IRREGULAR
NE. NE. NW. Sec. 20 Twp. 26S S, Rg. 31 W
375 490.5 Ft. from South Line of Section
2590 Ft. from ~~East~~ West Line of Section

CONTRACTOR: License # 5382 33375 2/2/05
Name Cheyenne Drilling LP
City/State Wichita, KS
Well Drilled as: New Recompletion OWWO
Projected Total Depth 2800' feet
Formation Chase

NOTE: Attach acreage attribution plat locating both Chase (Hugoton) wells
Total number of acres attributed to unit 640

If OWWO or Recompletion: old well info as follows:
Operator
Well Name
Comp. Date Old Total Depth

Nearest producing well from 2023 feet
same common source of supply
Nearest lease or unit boundary line 375 feet
County Finney
Lease Name Lightner Well # 1-2
Ground surface elevation 2838 feet MSL
Depth to bottom of fresh water 400'
Depth to bottom of usable water 1000'
Surface pipe by Alternate: 1 2
Surface pipe planned to be set 450'
Water Source for Drilled Operations:
DWR Permit #: well farm pond other

I certify that well will comply with K.S.A. 55-101, et seq., plus eventually plugging hole to KCC specifications.
Date 4-27-04 Signature of Operator or Agent Michelle Farrell Title Drilling Tech.


For KCC Use:
Conductor Pipe Required NONE feet; Minimum Surface Pipe Required 450 feet per Alt. (2)
This Authorization Expires 12-22-04 Approved By RJP 6-22-04

WLE 04-CONS-297-CWLE (6-22-04)

WELL LOCATION EXCEPTION GRANTED

Must be filed with K.C.C. five (5) days prior to commencing well
This card void if drilling not started within six (6) months of date received by K.C.C.

A Regular Section of Land
1 Mile = 5,280 Ft.

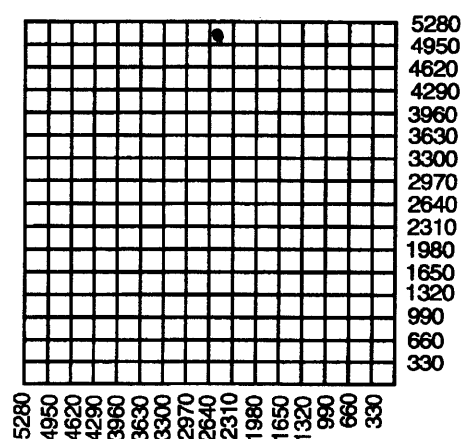

- Important procedures to follow:
1. Notify District office before setting surface casing.
 2. Set surface casing by circulating cement to the top.
 3. File completion forms ACO-1 with K.C.C. within 120 days of well spud date, following instructions on ACO-1, side 1, and including copies of wireline logs.
 4. Notify District office 48 hours prior to old well workover or re-entry.
 5. Submit plugging report (CP-4) to K.C.C. after plugging is completed.
 6. If an alternate 2 completion, cement in the production pipe from below any useable water to surface within 120 days of spud date.

State Corporation Commission of Kansas
Conservation Division
130 S. Market Room 2078
Wichita, Kansas 67202-1212
(316) 337-6231