

NOTICE OF INTENTION TO DRILL

CORRECTED
4-10-87

(see rules on reverse side)

Expected Spud Date: 4/10/87
month day year

API Number 15-135-23,105-0000
110' E & 110' S of

OPERATOR: License # 4767
Name Ritchie Exploration, Inc.
Address 125 N. Market, Suite 1000
City/State/Zip Wichita, KS 67202
Contact Person Rocky Milford
Phone 316/267-4375

NW NW SE Sec. 13 Twp. 20 S, Rg. 21 X East
* 2200 Ft. from South Line of Section
* 2200 Ft. from East Line of Section

(Note: Locate well on Section Plat on reverse side)

CONTRACTOR: License # 6033
Name Murfin Drilling Co.
City/State Wichita, KS 67202

Nearest lease or unit boundary line 330 feet
County Ness
Lease Name Franz Well # 1

Well Drilled For: Well Class: Type Equipment:
X Oil Storage Infield X Mud Rotary
Gas Inj Pool Ext Air Rotary
OWWO Expl X Wildcat Cable

Ground surface elevation 2227 feet MSL
Domestic well within 330 feet: yes X no
Municipal well within one mile: yes X no
Depth to bottom of fresh water 100
Depth to bottom of usable water 500
Surface pipe by Alternate: 1 2 X
Surface pipe planned to be set 280
Conductor pipe required none
Projected Total Depth 4400 feet
Formation Mississippian

If OWWO: old well info as follows:
Operator
Well Name
Comp Date Old Total Depth

I certify that well will comply with K.S.A. 55-101, et seq., plus eventually plugging hole to KCC specifications.
Date 4/08/87 Signature of Operator or Agent Rocky Milford Title Geologist

For KCC Use:
Conductor Pipe Required feet; Minimum Surface Pipe Required 200 feet per Alt. *
This Authorization Expires 9-12-87 Approved By 3-12-87


**Location was NW NW SE
APT#15-135-23,105

Must be filed with the K.C.C. five (5) days prior to commencing well
This card void if drilling not started within six (6) months of date received by K.C.C.

Important procedures to follow:

1. Notify District office before setting surface casing.
2. Set surface casing by circulating cement to the top.
3. File completion forms ACO-1 with K.C.C. within 120 days of well spud date, following instructions on ACO-1, side 1, and including copies of wireline logs.
4. Notify District office 48 hours prior to old well workover or re-entry.
Prior to filing Intent, prepare a proposed plugging plan in case well is D & A, then obtain approval of plan when calling district office prior to setting surface pipe.
Submit plugging report (CP-4) to K.C.C. after plugging is completed.
Obtain an approved injection docket number before disposing of salt water.
8. Notify K.C.C. within 10 days when injection commences or terminates.
9. If an alternate 2 completion, cement in the production pipe from below any usable water to surface within 120 days of spud date.

A Regular Section of Land 1 Mile = 5,280 Ft.

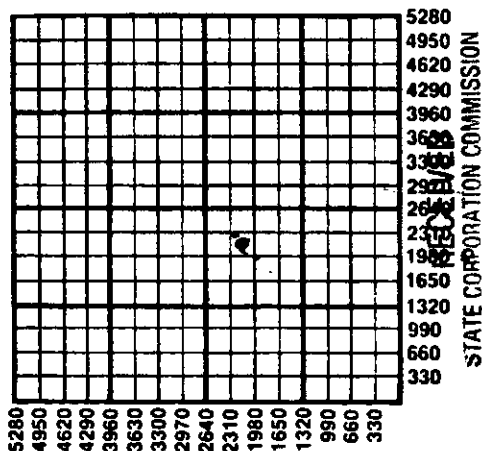

State Corporation Commission of Kansas
Conservation Division
200 Colorado Derby Building
Wichita, Kansas 67202-1212
(316) 263-3238