

NOTICE OF INTENTION TO DRILL

(see rules on reverse side)

10

Starting Date Nov. 27, 1987
month day year

API Number 15-135-23,193-0000

OPERATOR: License # 5097
Name Martin Oil Producers, Inc.
Address 1010 Union Center
City/State/Zip Wichita, KS 67202
Contact Person Joe Moreland
Phone 264-0352

C NE NW Sec 36 Twp 20 S, Rg 24 East
4620 Ft. from South Line of Section
3300 Ft. from East Line of Section

(Note: Locate well on Section Plat on reverse side)

CONTRACTOR: License # 5145
Name Dreilling Oil, Inc.
City/State Victoria, KS

Nearest lease or unit boundary line 660 feet
County Ness
Lease Name McCreight Well # 1

Well Drilled For: Well Class: Type Equipment:
 Oil SWD Infield Mud Rotary
 Gas Inj Pool Ext. Air Rotary
 OWWO Expl Wildcat Cable

Ground surface elevation 2270 feet MSL
Domestic well within 330 feet: yes no
Municipal well within one mile: yes no
Surface pipe by Alternate: 1 2
Depth to bottom of fresh water 310
Depth to bottom of usable water 660
Surface pipe planned to be set 690
Projected Total Depth 4425 feet
Formation Mississippian

If OWWO: old well info as follows:

Operator
Well Name
Comp Date Old Total Depth

I certify that well will comply with K.S.A. 55-101, et seq., plus eventually plugging hole to KCC specifications.

cementing will be done immediately upon setting production casing
Date 11/20/87 Signature of Operator or Agent [Signature] Title Geologist

For KCC Use:


Conductor Pipe Required feet; Minimum Surface Pipe Required 680 feet per Alt. 1 X
This Authorization Expires 5-20-88 Effective 11-25-87 Approved By 11-20-87

Must be filed with the K.C.C. five (5) days prior to commencing well
This card void if drilling not started within six (6) months of date received by K.C.C.

Important procedures to follow:

1. Notify District office before setting surface casing.
2. Set surface casing by circulating cement to the top.
3. File completion forms ACO-1 with K.C.C. within 90 days of well completion, following instructions on ACO-1, side 1, and including copies of wireline logs.
4. Notify District office 48 hours prior to old well workover or re-entry.
5. Prior to filing Intent, prepare a proposed plugging plan in case well is D & A, then obtain approval of plan when calling district office prior to setting surface pipe.
6. Submit plugging report (CP-4) to K.C.C. after plugging is completed.
7. Obtain an approved injection docket number before disposing of salt water.
8. Notify K.C.C. within 10 days when injection commences or terminates.
9. If an alternate 2 completion, cement in the production pipe from below any usable water to surface within 120 days of spud date.

A Regular Section of Land 1 Mile = 5,280 Ft.

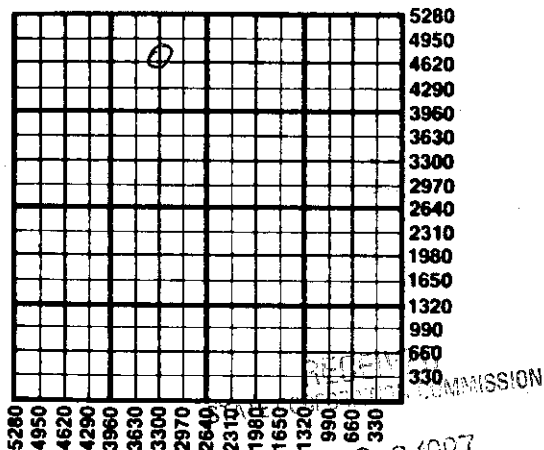

NOV 20 1987
CONSERVATION DIVISION
Wichita, Kansas

State Corporation Commission of Kansas
Conservation Division
200 Colorado Derby Building
Wichita, Kansas 67202
(316) 263-3238