

15-165-01959-0000

ll

WELL PLUGGING RECORD


STATE OF KANSAS
STATE CORPORATION COMMISSION

Give All Information Completely
Make Required Affidavit
Mail or Deliver Report to:
Conservation Division
State Corporation Commission
212 North Market, Insurance Bldg.
Wichita, Kansas

Rush County, Sec. 33 Twp 19 Rge. 16 (●) W (W)

Location as "NE/CNW/SW" or footage from lines SE SE NE
Lease Owner Alkay Oil Company
Lease Name William Nagaa Well No. 1
Office Address Great Bend, Kansas R. R. # 7
Character of Well (completed as Oil, Gas or Dry Hole) oil
Date well completed June 21, 1947 1947
Application for plugging filed July 7 1961
Application for plugging approved July 7 1961
Plugging commenced July 7 1961
Plugging completed July 7 1961
Reason for abandonment of well or producing formation depleted

NORTH

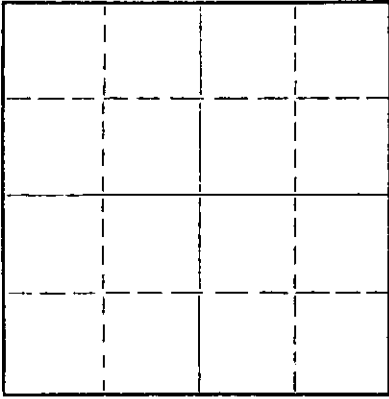

Locate well correctly on above
Section Plat

If a producing well is abandoned, date of last production May 1 1961
Was permission obtained from the Conservation Division or its agents before plugging was com-
menced? yes

Name of Conservation Agent who supervised plugging of this well Eldon Petty
Producing formation Arbuckle Depth to top 3710' Bottom 3759 Total Depth of Well 3759 Feet
Show depth and thickness of all water, oil and gas formations.

OIL, GAS OR WATER RECORDS

CASING RECORD

FORMATION	CONTENT	FROM	TO	SIZE	PUT IN	PULLED OUT
				8 5/8	730'	none
				5 1/2	3730'	none

Describe in detail the manner in which the well was plugged, indicating where the mud fluid was placed and the method or methods used in introducing it into the hole. If cement or other plugs were used, state the character of same and depth placed, from _____ feet to _____ feet for each plug set.

Plugged back with sand to 3720' / Mixed and put in 5 ax. cement from 3720' to 3680'. Filled hole with mud from 3680' to 475'. Set rock bridge from 475' to 450'. Filled hole with cement from 450' to base of cellar.

RECEIVED
STATE CORPORATION COMMISSION

JUL 18 1961
7-18-61
CONSERVATION DIVISION
Wichita, Kansas

(If additional description is necessary, use BACK of this sheet)

Name of Plugging Contractor Ace Pipe Pulling Company
Address Great Bend, Kansas

STATE OF Oklahoma, COUNTY OF Tulsa, ss.
E. G. Moehlenkamp (employee of owner) or (~~owner or operator~~) of the above-described

well, being first duly sworn on oath, says: That I have knowledge of the facts, statements, and matters herein contained and the log of the above-described well as filed and that the same are true and correct. So help me God.

(Signature) E. G. Moehlenkamp

(Address)

SUBSCRIBED AND SWORN to before me this 17 day of July, 1961

My commission expires 5/3/64

Josephine Rawley
Notary Public.



Commenced June 2, '47
 Completed June 21, '47
 I. P. Elowed ## 1-3/4 bbls per hour

0 - 70	clay and shells	3680 - 3685	lime-gray little porosity
70 - 110	clay	3685 - 3695	lime-gray-red & blue shale
110 - 140	sand	3695 - 3710	lime-gray with various colored shales
140 - 350	shale and shells		
350 - 420	sand		3710 ARBUCKLE
420 - 460	shale-shells	3710 - 3729	dolomite-gas-good porosity
460 - 580	sand	3729 - 3753	dolomite-gas & oil
580 - 615	shale-shells		3753 Rotary T.D.
615 - 675	sand	3753 - 3759	(Cable Tools) some saturation
675 - 680	shale-shells		3759 T.D.
680 - 700	red beds		
700 - 730	red beds & shells		Drilled plug 6-25-47
730 - 1065	red beds-shale		Estimated 10 million gas & oil bbls. oil per hour
1065 - 1087	anhydrite		
1087 - 1350	red beds-shale		
1350 - 1425	salt		8 5/8" set at 730' 675 sacks
1425 - 1510	red beds&shale		5 1/2" set at 3730' 150 sacks
1510 - 1535	salt		
1535 - 1795	shale&shells		
1795 - 1924	lime&shale		
1924 - 2150	shale&shells		
2150 - 2185	lime		
2185 - 2230	sandy lime		
2230 - 2375	lime		
2375 - 2395	lime&shale		
2395 - 2445	shale		
2445 - 2565	shale&shells		
2565 - 2660	lime&shale		
2660 - 2730	shale&shells		
2730 - 2815	shale		
2815 - 2895	lime&shale		
2895 - 2905	shale		
2905 - 2955	lime&shale		
2955 - 3000	lime		
3000 - 3035	lime&shale		
	3025 TOPEKA		
3035 - 3055	lime		
3055 - 3085	shale&sand		
3085 - 3230	lime		
3230 - 3255	shale		
3255 - 3345	lime-broken		
3345 - 3364	lime&shale		
3364 - 3409	lime		
	3410 KANSAS CITY		
3409 - 3427	lime		
3427 - 3431	lime		
3431 - 3441	lime		
3441 - 3454	lime-gray-porous		
3454 - 3482	lime-gray		
3482 - 3484	lime-stain-little porosity		
3484 - 3495	lime		
3495 - 3499	lime-soft		
3499 - 3503	lime		
3503 - 3515	lime-soft-stain-very porous		
3515 - 3537	lime		
3537 - 3543	lime		
3543 - 3558	lime		
3558 - 3568	lime-soft-porous		
3568 - 3590	lime&shale		
3590 - 3626	lime		
3626 - 3674	lime-broken		
3674 - 3678	lime-gray little sand		
3678 - 3680	lime		

RECEIVED
 STATE CORPORATION COMMISSION
 JUL 11 1961
 7-11-61
 CONSERVATION DIVISION
 Wichita, Kansas