

STATE CORPORATION COMMISSION OF KANSAS
OIL & GAS CONSERVATION DIVISION

WELL COMPLETION OR RECOMPLETION FORM
ACO-1 WELL HISTORY

DESCRIPTION OF WELL AND LEASE

Operator: License # 5020
Name Rine Exploration Company
Address Suite #645, 300 W. Douglas
City/State/Zip Wichita, KS 67202

Purchaser NA - Shut-in

Operator Contact Person M. Bradford Rine
Phone 316/262-5418

Contractor: License # 5381
Name Big Springs Drilling, Inc.

Wellsite Geologist Tom McElroy
Phone 316/262-5418

Designate Type of Completion

- New Well Re-Entry Workover
- Oil SWD Temp Abd
- Gas Inj Delayed Comp.
- Dry Other (Core, Water Supply etc.)

If OWWO: old well info as follows:

Operator
Well Name
Comp. Date Old Total Depth

WELL HISTORY

Drilling Method:

- Mud Rotary Air Rotary Cable

06/17/85 06/28/85 07/25/85
Spud Date Date Reached TD Completion Date
4650' 4605'
Total Depth PBTB

Amount of Surface Pipe Set and Cemented at 301 feet
Multiple Stage Cementing Collar Used? Yes No
If yes, show depth set feet
If alternate 2 completion, cement circulated from feet depth to w/SX cmt

API NO. 15-007-22,053-00-00
County Barber
C NE 1/4 NW 1/4 Sec 7 Twp 32S Rge 12W West

4620 Ft North from Southeast Corner of Section
3300 Ft West from Southeast Corner of Section
(Note: Locate well in section plat below)


Lease Name Vanderwork Well # 1-7

Field Name Medicine River Southwest

Producing Formation Mississippian

Elevation: Ground 1527 KB 1532

Section Plat

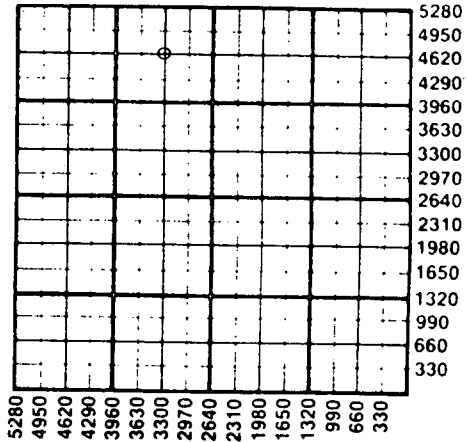

WATER SUPPLY INFORMATION

Disposition of Produced Water: Disposal Repressuring
Docket #

Questions on this portion of the ACO-1 call:

Water Resources Board (913) 296-3717

Source of Water: BOUGHT FROM - G.C. VANDERWORK
Division of Water Resources Permit #

- Groundwater Ft North from Southeast Corner (Well) Ft West from Southeast Corner of Sec Twp Rge East West
- Surface Water Ft North from Southeast Corner (Stream, pond etc) Ft West from Southeast Corner Sec 7 Twp 32S Rge 12W East West
- Other (explain) (purchased from city, R.W.D. #)

INSTRUCTIONS: This form shall be completed in duplicate and filed with the Kansas Corporation Commission, 200 Colorado Derby Building, Wichita, Kansas 67202, within 90 days after completion or recompletion of any well. Rule 82-3-130 and 82-3-107 apply. Information on side two of this form will be held confidential for a period of 12 months if requested in writing and submitted with the form. See rule 82-3-107 for confidentiality in excess of 12 months. One copy of all wireline logs and drillers time log shall be attached with this form. Submit CP-4 form with all plugged wells. Submit CP-111 form with all temporarily abandoned wells.

All requirements of the statutes, rules and regulations promulgated to regulate the oil and gas industry have been fully complied with and the statements herein are complete and correct to the best of my knowledge.

Signature M. Bradford Rine
Title President Date 10/02/85

Subscribed and sworn to before me this 2nd day of October 1985
Notary Public Ginger L. Mitchell
Date Commission Expires June 11, 1988

K.C.C. OFFICE USE ONLY
 Letter of Confidentiality Attached
 Wireline Log Received
 Drillers Timelog Received
Distribution
 KCC SWD/Rep NGPA
 KGS Plug Other (Specify)

GINGER L. MITCHELL
NOTARY PUBLIC
STATE OF KANSAS
MY APPT. EXPIRES 06-11-88

Form ACO-1 (7-84)
OCT 3 1985

DST #2 - 4251' to 4270' (Miss. Chert) 30-60-60-60. Blow: strong, gas to surface - 4 min. Rec.: 70' oil cut mud, 60' muddy oil, 240' oil, 60' water.

IFP 127 - 177 ISIP 1424

FFP 177 - 226 FSIP 1404

Gas Gauges as follows:

10 min. - 175,000 CFGPD

20 min. - 219,000 CFGPD

30 min. - 274,000 CFGPD

Final Flow:

10 min. - 344,000 CFGPD

20 min. - 357,000 CFGPD

30 min. - 370,000 CFGPD

40 min. - 398,000 CFGPD

50 min. - 411,000 CFGPD

60 min. - 411,000 CFGPD

CONFIDENTIAL

SAMPLE TOPS

| | | | |
|---------------|------------|--------------------|------------|
| Chase | 1825 - 293 | Heebner | 3535 -2003 |
| Winfield | 1890 - 358 | Toronto | 3557 -2025 |
| Towanda | 1955 - 423 | Lower Douglas Sand | 3689 -2157 |
| Fort Riley | 2005 - 473 | Lansing | 3731 -2199 |
| Base Florence | 2100 - 568 | Drum | 3959 -2427 |
| Cottonwood | 2370 - 838 | Stark | 4085 -2553 |
| Onaga | 2637 -1105 | Hushpuckney | 4117 -2585 |
| Wabaunsee | 2698 -1166 | Mississippian | 4234 -2702 |
| Stotler | 2843 -1311 | Kinderhook | 4475 -2893 |
| Tarkio | 2880 -1348 | Viola | 4517 -2985 |
| Bern | 2955 -1423 | Simpson Sandstone | 4613 -3081 |
| Topeka | 3083 -1551 | RTD | 4650 -3118 |

OCT 14 1985

State Geological Survey
WICHITA BRANCH

RECEIVED
STATE CORPORATION COMMISSION

OCT 3 1985

CONSERVATION DIVISION
Wichita, Kansas