

This form shall be filed in duplicate with the Kansas Corporation Commission, 200 Colorado Derby Building, Wichita, Kansas 67202, within ten days after the completion of the well, regardless of how the well was completed.

Attach separate letter of request if the information is to be held confidential. If confidential, only file one copy. Information on side one will be of public record and side two will then be held confidential.

Circle one: Oil, Gas, Dry, SWD, OWWO, Injection. Type and complete ALL sections.

Applications must be filed for dual completion, commingling, SWD and injection, T.A.

Attach wireline logs (i.e. electrical log, sonic log, gamma ray neutron log, etc.). KCC # (316) 263-3238. (Rules 82-2-105 & 82-2-125)

OPERATOR Eagle Explorations, Inc.

API NO. 15-007-21,359-00-00

ADDRESS 107 N. Market, Suite 300

COUNTY Barber

Wichita, Kansas 67202

FIELD Bloom

\*\*CONTACT PERSON D. R. Ramsay PHONE 265-2897

PROD. FORMATION Plugged

PURCHASER

LEASE Vanderwork

ADDRESS

WELL NO. #1

WELL LOCATION SE-SE-SW

DRILLING MacDonalD Drilling, Inc.

330 Ft. from South Line and

CONTRACTOR

2310 Ft. from West Line of

ADDRESS 107 N. Market, Suite 300

the SW/4 SEC. 14 TWP. 32 RGE. 12W

Wichita, Kansas 67202

WELL PLAT

PLUGGING MacDonalD Drilling, Inc.

CONTRACTOR

ADDRESS 107 N. Market, Suite 300


Wichita, Kansas 67202

TOTAL DEPTH 4872 PBTD Surface

SPUD DATE 2-24-82 DATE COMPLETED 3-16-82

ELEV: GR 1507 DF 1520 KB 1521

DRILLED WITH (CABLE) (ROTARY) (AIR) TOOLS

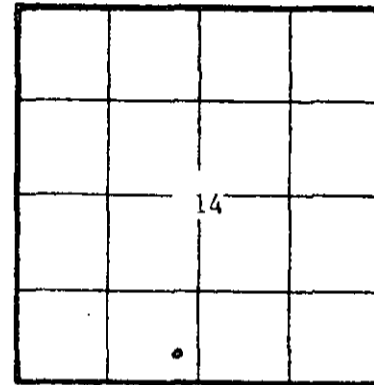

KCC [check] KGS [check] (Office Use)

Amount of surface pipe set and cemented 403 DV Tool Used? No

AFFIDAVIT

STATE OF Kansas, COUNTY OF Barber SS, I,

D. R. Ramsay OF LAWFUL AGE, BEING FIRST DULY SWORN UPON HIS OATH,

DEPOSES THAT HE IS Drilling Superintendent (FOR)(OF) Eagle Explorations, Inc.


OPERATOR OF THE Vanderwork LEASE, AND IS DULY AUTHORIZED TO MAKE

THIS AFFIDAVIT FOR AND ON THE BEHALF OF SAID OPERATOR, THAT WELL NO. #1 ON SAID LEASE HAS BEEN COMPLETED AS OF THE 16th DAY OF March, 19 82, AND THAT ALL INFORMATION ENTERED HEREIN WITH RESPECT TO SAID WELL IS TRUE AND CORRECT.

CONSERVATION DIVISION FURTHER AFFIANT SAITH NOT.

(S) D. R. Ramsay

SUBSCRIBED AND SWORN BEFORE ME THIS 24th DAY OF March, 19 82.

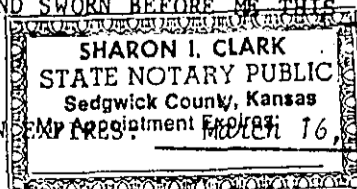

Sharon I. Clark NOTARY PUBLIC SHARON I. CLARK

\*\*The person who can be reached by phone regarding any questions concerning this information. Within 45 days of completion, a witnessed initial test by the Commission is required if the well produces more than 25 BOPD or is located in a Basic Order Pool.