


STATE OF KANSAS
STATE CORPORATION COMMISSION

Form CP-4

WELL PLUGGING RECORD

Give All Information Completely
Make Required Affidavit
Mail or Deliver Report to:
Conservation Division
State Corporation Commission
311 No. Broadway
Wichita, Kansas

NORTH

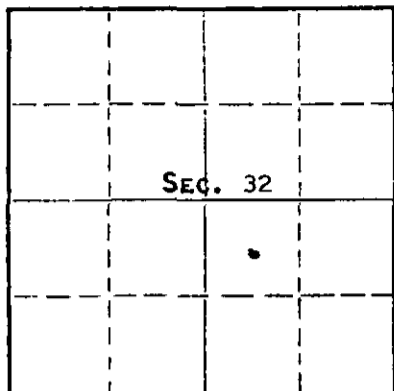

Locate well correctly on above
Section Plat

BARBER County. Sec. 32 Twp. 32s Rge. 12 (E) (W)
Location as "NE/CNW/SW" or footage from lines. C NW SE
Lease Owner PETROLEUM, INC.
Lease Name BOGGS Well No. 1
Office Address R.R. #2, GREAT BEND, KANSAS
Character of Well (completed as Oil, Gas or Dry Hole) DRY HOLE
Date well completed JAN. 4 19 66
Application for plugging filed JAN. 4 19 66
Application for plugging approved JAN. 4 19 66
Plugging commenced JAN. 4 19 66
Plugging completed JAN. 4 19 66
Reason for abandonment of well or producing formation NO PRODUCEABLE ZONE

If a producing well is abandoned, date of last production NONE 19
Was permission obtained from the Conservation Division or its agents before plugging was commenced? YES

Name of Conservation Agent who supervised plugging of this well ARCHIE ELYING
Producing formation _____ Depth to top _____ Bottom _____ Total Depth of Well 4690' Feet
Show depth and thickness of all water, oil and gas formations.

OIL, GAS OR WATER RECORDS

CASING RECORD

FORMATION	CONTENT	FROM	TO	SIZE	PUT IN	PULLED OUT
				8-5/8"	319'	NONE

Describe in detail the manner in which the well was plugged, indicating where the mud fluid was placed and the method or methods used in introducing it into the hole. If cement or other plugs were used, state the character of same and depth placed, from _____ feet to _____ feet for each plug set.

MUDDED UP WITH HEAVY MUD TO 300', FOLLOWED BY BRIDGE, PLACED 1/2 SACK HULLS AND 1/2 SACK DRY CEMENT AND 24 1/2 SACKS CEMENT ON TOP OF BRIDGE. MUDDED UP WITH HEAVY MUD TO 40', FOLLOWED BY 1 SACK DRY CEMENT, 1/3 SACK HULLS AND 9 SACKS CEMENT TO BASE OF WELL CELLAR.

RECEIVED
JAN 17 1966
CONSERVATION DIVISION

(If additional description is necessary, use BACK of this sheet)

Name of Plugging Contractor GARVEY DRILLING COMPANY
Address R.R. #2, GREAT BEND, KANSAS

STATE OF KANSAS COUNTY OF BARTON ss.
MONTE CHADD (employee of owner) or (owner) of the above-described well, being first duly sworn on oath, says: That I have knowledge of the facts, statements, and matters herein contained and the log of the above-described well as filed and that the same are true and correct. So help me God. MONTE CHADD, DIST. PROD. SUPT.

(Signature) *Monte Chadd*
R.R. #2, GREAT BEND, KANSAS
(Address)

SUBSCRIBED AND SWORN TO before me this 13 day of JANUARY, 19 66

My commission expires MAY 28, 1969 *Richard H. Dumas* Notary Public.

WELL LOG

COMPANY Petroleum, Inc.

SEC. 32 T. 32S R. 12W

FARM Boggs NO. 1

LOC. C NW SE


TOTAL DEPTH 4690'

COUNTY Barber

COMM. 12-20-65 COMP. 1-4-66

CONTRACTOR Garvey Drilling Company

CASING 8 5/8" @ 319' w/250 sx

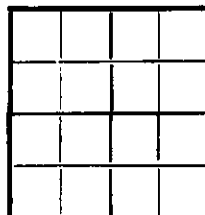

ELEVATION 1801' KB

PRODUCTION D & A

FIGURES INDICATE BOTTOM OF FORMATIONS

200' Red Bed and Sand
319' Red Bed
1460' Shale and Red Bed
1660' Shale and Lime
2885' Lime and Shale
3150' Shale and Lime
3159' Lime
3960' Lime and Shale
3985' Sand
4095' Lime with Shale
4155' Lime
4195' Lime and Chalk
4465' Lime
4507' Lime and Shale
4623' Lime
4638' Lime and Shale
4654' Mississippi Chat
4690' Mississippi Chert
4690' RTD

RECORDED
STATE OF KANSAS

JAN 17 1966

CONSERVATION DIVISION
WICHITA, KANSAS

State of Kansas }
County of Barton } SS

I, Sam N. Stephens of Garvey Drilling Company

upon oath state the above and foregoing is a true and correct copy of the log of the Boggs No. 1 well.

Sam N. Stephens

Subscribed and sworn to before me this 12th day of January 19 66

My Commission Expires: November 5, 1969

Richard Boyd
NOTARY PUBLIC