


STATE OF KANSAS  
STATE CORPORATION COMMISSION

Give All Information Completely  
Make Required Affidavit  
Mail or Deliver Report to:  
Conservation Division  
State Corporation Commission  
800 Bittling Building  
Wichita, Kansas

WELL PLUGGING RECORD

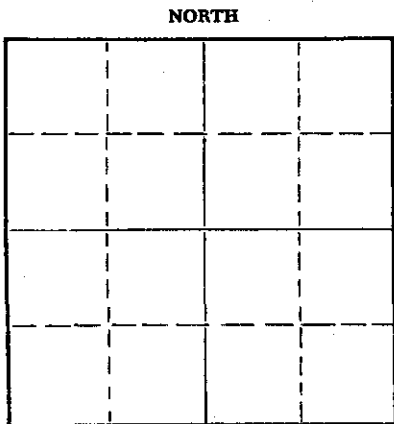

Locate well correctly on above  
Section Plat

Barber County, Sec. 31 Twp. 32 Rge. (E) 12 (W)  
Location as "NE/CNW/SW" or footage from lines SW NW NE  
Lease Owner Rupp-Ferguson Oil Co.  
Lease Name Lonker Well No. 1  
Office Address 523 Petroleum Bldg.  
Character of Well (completed as Oil, Gas or Dry Hole) Dry Hole  
Date well completed 8-3-55 19  
Application for plugging filed 8-3-55 19  
Application for plugging approved 8-3-55 19  
Plugging commenced 8-3-55 19  
Plugging completed 8-3-55 19  
Reason for abandonment of well or producing formation

If a producing well is abandoned, date of last production 19  
Was permission obtained from the Conservation Division or its agents before plugging was commenced? Yes

Name of Conservation Agent who supervised plugging of this well M. A. Rives  
Producing formation Depth to top Bottom Total Depth of Well 4949 Feet  
Show depth and thickness of all water, oil and gas formations.

OIL, GAS OR WATER RECORDS

CASING RECORD

FORMATION	CONTENT	FROM	TO	SIZE	PUT IN	PULLED OUT
				8 5/8	275	0

Describe in detail the manner in which the well was plugged, indicating where the mud fluid was placed and the method or methods used in introducing it into the hole. If cement or other plugs were used, state the character of same and depth placed, from feet to feet for each plug set.

Filled to 280', 1 1/2 sacks hulls, plug 20 sacks cem. thru d.p. Filled hole to 35', 10 sacks cem.

RECEIVED  
CORPORATION COMMISSION

8-9-55

CONSERVATION DIVISION  
Wichita, Kansas

(If additional description is necessary, use BACK of this sheet)

Name of Plugging Contractor Rupp-Ferguson Oil Co.  
Address 523 Petroleum Bldg., Wichita, Kansas

STATE OF Kansas COUNTY OF Sedgwick ss.  
L. W. Knox (employee of owner) or (owner or operator) of the above-described well, being first duly sworn on oath, says: That I have knowledge of the facts, statements, and matters herein contained and the log of the above-described well as filed and that the same are true and correct. So help me God.

(Signature) [Signature]  
523 Petroleum Bldg., Wichita, Kansas  
(Address)

SUBSCRIBED AND SWORN to before me this 5th day of August, 19 55

[Signature]

Notary Public.

My commission expires 6-4-59

PLUGGING  
FILE SEC 31 T 32 R 12W  
BOOK PAGE 40 LINE 16

CONTRACTOR'S LOG

Rupp-Ferguson No. 1 Lunker  
SW NW NE, Sec. 31-32-12W, Barber County, Kansas  
Contractor: Rupp-Ferguson Oil Co.  
Commenced: 7-15-55  
Completed: 8-3-55

Elevation 1696 KB

Set 375' of 8 5/8" surface casing w/225 sacks cement

D & A

Figures Indicate Bottom of Formation

284 red rock  
1150 red bed, shale & shells  
1460 shale & shells  
1606 salt  
1785 lime & shale  
1885 lime  
3130 lime & shale  
3327 lime  
3492 lime & shale  
3596 sandy lime & shale  
3782 lime & shale  
3844 shale  
3898 sandy shale  
3970 shale-sand-lime  
4065 lime  
4098 lime & shale  
4398 lime  
4533 lime & shale  
4733 Miss.  
4831 Kinderhook  
4910 Viola  
4949 Simpson  
T.D.

STATE OF KANSAS )  
 ) SS:  
COUNTY OF SEDGWICK)

I, L. W. Knox, Landman for Rupp-Ferguson Oil Co., do hereby certify that the above and foregoing is a true and correct copy of the log of the No. 1 Lunker.

*L. W. Knox*  
L. W. KNOX

Subscribed and sworn to before me this 5th day of August, 1955.

RECEIVED  
STATE CORPORATION COMMISSION

*Helen Horine*  
Notary Public

My Commission Expires June 4, 1959

AUG 9 X 1955

CONSERVATION DIVISION  
Wichita, Kansas

PLUGGING  
FILE SEC 31 T 32 R 12W  
BOOK PAGE 140 LINE 16