


STATE OF KANSAS
STATE CORPORATION COMMISSION

Form CP-4

Give All Information Completely
Make Required Affidavit
Mail or Deliver Report to:
Conservation Division
State Corporation Commission
212 No. Market
Wichita, Kansas

WELL PLUGGING RECORD

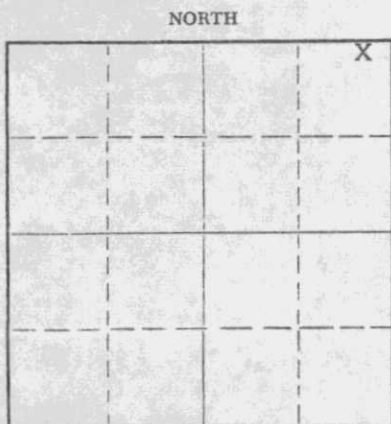

Locate well correctly on above
Section Plat

Barber County. Sec. 36 Twp. 32 Rge. 12 (E) (W)
Location as "NE/CNW/SW" or footage from lines. NE NE NE
Lease Owner Roland Estate
Lease Name MacGregor Well No. 3
Office Address _____
Character of Well (completed as Oil, Gas or Dry Hole) _____
Date well completed _____ 19____
Application for plugging filed _____ 19____
Application for plugging approved _____ 19____
Plugging commenced November 24 1969
Plugging completed December 1 1969
Reason for abandonment of well or producing formation _____
Not commercial

If a producing well is abandoned, date of last production _____ 19____
Was permission obtained from the Conservation Division or its agents before plugging was commenced? Yes

Name of Conservation Agent who supervised plugging of this well Herman Justus
Producing formation _____ Depth to top _____ Bottom _____ Total Depth of Well 3722 Feet
Show depth and thickness of all water, oil and gas formations.

OIL, GAS OR WATER RECORDS

CASING RECORD

FORMATION	CONTENT	FROM	TO	SIZE	PUT IN	PULLED OUT
				8 5/8	219	None
				4 1/2	3721	2771

Describe in detail the manner in which the well was plugged, indicating where the mud fluid was placed and the method or methods used in introducing it into the hole. If cement or other plugs were used, state the character of same and depth placed, from _____ feet to _____ feet for each plug set.

Dumped chat From 3721 to 3540
Cement - 5 sacks from Dump Bailer From 3540 to 3490
Built wood bridge at 219 feet. Rock from 219 to 209. Dumped Ready Mix Cement - 4 yards - from 209 to top.

RECEIVED
STATE CORPORATION COMMISSION
JAN 27 1970
CONSERVATION DIVISION
Wichita, Kansas

(If additional description is necessary, use BACK of this sheet)
Name of Plugging Contractor Clarke Oilfield Service, Inc.
Address Box 187, Medicine Lodge, Kansas 67104

STATE OF Kansas, COUNTY OF Barber, ss.
Elmo Morgenstern (employee of owner) or (owner or operator) of the above-described well, being first duly sworn on oath, says: That I have knowledge of the facts, statements, and matters herein contained and the log of the above-described well as filed and that the same are true and correct. So help me God.

(Signature) Elmo Morgenstern

(Address)

SUBSCRIBED AND SWORN TO before me this 24th day of January, 19 70

Jessie Harrison
Notary Public.

My commission expires April 4, 1970