


Give All Information Completely
Make Required Affidavit
Mail or Deliver Report to:
Conservation Division
State Corporation Commission
211 No. Broadway
Wichita, Kansas

WELL PLUGGING RECORD

Barber County, Sec. 35 Twp. 32S Rge. (E) 12(W)

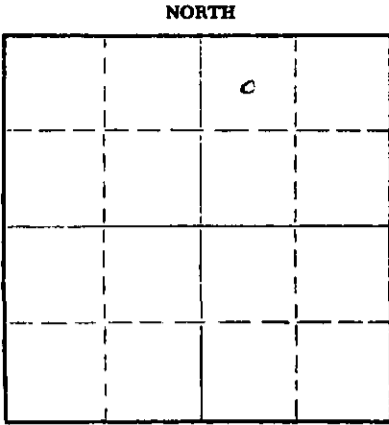

Locate well correctly on above Section Plat

Location as "NE/CNWxSWx" or footage from lines C NW NE
Lease Owner Aurora Gasoline Company
Lease Name LONG Well No. 1
Office Address 1107 Union National Bldg., Wichita, Kansas
Character of Well (completed as Oil, Gas or Dry Hole) dry hole
Date well completed 10-22-58 19
Application for plugging filed 10-22-58 19
Application for plugging approved 10-22-58 19
Plugging commenced 10-22-58 19
Plugging completed 10-22-58 19
Reason for abandonment of well or producing formation dry hole

If a producing well is abandoned, date of last production 19
Was permission obtained from the Conservation Division or its agents before plugging was commenced? Yes

Name of Conservation Agent who supervised plugging of this well Bill Lackamp
Producing formation _____ Depth to top _____ Bottom _____ Total Depth of Well 4711 Feet
Show depth and thickness of all water, oil and gas formations.

OIL, GAS OR WATER RECORDS

CASING RECORD

FORMATION	CONTENT	FROM	TO	SIZE	PUT IN	PULLED OUT
				8-5/8"	215'	none

Describe in detail the manner in which the well was plugged, indicating where the mud fluid was placed and the method or methods used in introducing it into the hole. If cement or other plugs were used, state the character of same and depth placed, from _____ feet to _____ feet for each plug set.

Filled hole with heavy mud to 210 feet. Set Wood Plug at 210 feet; 20 sacks cement 150 feet to 210 feet; heavy mud 40 feet to 150 feet; set wood plug at 40 feet; 10 sacks cement 0 to 40 feet.

(If additional description is necessary, use BACK of this sheet)

Name of Plugging Contractor Beardmore Drilling Company
Address 827 Beacon Building, Wichita, Kansas

STATE OF Kansas, COUNTY OF Sedgwick, ss.
Everest E. Wible (employee of owner) of the above-described well, being first duly sworn on oath, says: That I have knowledge of the facts, statements, and matters herein contained and the log of the above-described well as filed and that the same are true and correct. So help me God.

(Signature) Everest E. Wible
1107 Union National Bldg., Wichita, Kansas
(Address)

SUBSCRIBED AND SWORN TO before me this 29th day of October

My commission expires November 14, 1960

Helen Suellentrop Notary Public.

PLUGGING
NO. 35 T 32 R 12W
PAGE 143 LINE 4

11-6-58

BEARDMORE-AURORA
#1 Long
NW NE Section 35-32-12W
Barber County, Kansas

Drilled By: Beardmore Drilling Company
Drilling Commenced: 9-30-58
Drilling Completed: 10-21-58

Casing Record:

8-5/8" set at 215' with 150 sacks. Cement circulated. 9-30-58.

Elevations: 1439 KB
1436 DF
1434 Gr

FORMATIONS

DEPTH

Cellar and Soil	10
Red Bed	215
Red Bed	900
Shale and Shells	1460
Shale and Lime	1640
Lime	1785
Lime and Shale	1915
Lime	2050
Lime and Shale	3611
Sand and Shale	3716
Lime	3740
Lime and Shale	3810
Lime	4195
Lime and Shale	4250
Lime	4309
Chert and Lime	4584
Lime	4420
Lime and Chert	4455
Lime	4520
Lime and Shale	4577
Lime	4600
Lime and Shale	4670
Shale	4677
Sand	4685
Sand and Shale (?)	4690
Sand	4711
Rotary Total Depth	4711

LOG TOPS

Elgin	3350
Heebner	3538
Lansing	3714
Mississippi	4304
Kinderhook	4481
Chattanooga	4558
Viola	4594
Simpson	4676
Total Depth	4710

DST #1 3566-3591 Straddle Test-Shut in 30 min., open 1 hr., shut in 30 min. Recovered 45' very slightly gas cut salt water. IBHP 1200, FBHP 1080, FP 25, Hydrostatic 2060, Temperature 105°.

PLUGGING
FILE SEC 35 T 32 R 12W
BOOK PAGE 143 LINE 19

RECEIVED
STATE COMMISSION
OCT 21 6-58
CON-
FISH IN

BEARDMORE-AURORA

#1 Long
Well Log

Page 2

DST #2 4309-4339 Shut in 30 min., open 1 hr., shut in 30 min., weak blow. Recovered 30' mud. IBHP 55, IF 28, FF 40, FBHP 55, Hydrostatic 2458, Temp. 107⁰.

DST #3 4675-4685 Shut in 30 min., open 30 min., shut in 30 min. Recovered 7' mud. IBHP 30, FP 10, FBHP 30, Hydrostatic 2620, No blow.

DST #4 4680-4690 Shut in 30 min., open 2 hrs., shut in 30 min. Recovered 330' salt water. IBHP 1800, FP 25, FBHP 1675, Hydrostatic 2635, Temp. 132⁰.

STATE OF KANSAS)
) ss
COUNTY OF SEDGWICK)

I, the undersigned, being duly sworn on oath state that the above and within statement is a true and correct record and log of the well drilled on the location above described, to the best of my knowledge and belief.

Bob Beardmore

Subscribed and sworn to before me this 31st day of October, 1958.

Leonard P. Tolle
Leonard P. Tolle-Notary Public

My Commission Expires:
January 28, 1960

RECEIVED
COMMISSION
11-6-58

PLUGGING
FILE SEC. 35 T. 32 R. 12W
BOOK PAGE 143 LINE 19