


STATE OF KANSAS
STATE CORPORATION COMMISSION

WELL PLUGGING RECORD

Give All Information Completely
Make Required Affidavit
Mail or Deliver Report to
Conservation Division
State Corporation Comm.
245 North Water
Wichita, KS 67202

Barber County. Sec. 34 Twp. 32S Rge. 12 E/W
Location as "NE/CNW 1/4 SW 1/4" or footage from lines
C SW SW

Lease Owner Patrick Petroleum Corporation
Lease Name Moots Well No. 1
Office Address Suite 400 - One Twenty Building - Wichita, Ks.
Character of Well (Completed as Oil, Gas or Dry Hole)

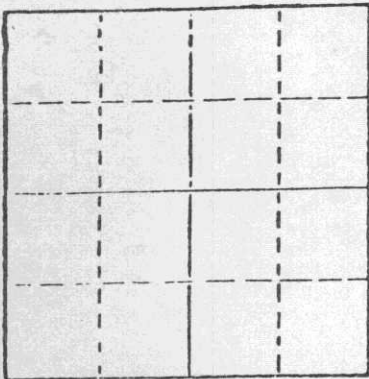

Locate well correctly on above
Section Plat

Dry Hole
Date Well completed January 27, 1978
Application for plugging filed January 27, 1978
Application for plugging approved January 27, 1978
Plugging commenced January 27, 1978
Plugging completed January 27, 1978
Reason for abandonment of well or producing formation
dry hole

If a producing well is abandoned, date of last production
19

Was permission obtained from the Conservation Division or
its agents before plugging was commenced? yes

Name of Conservation Agent who supervised plugging of this well Bill Owen
Producing formation Depth to top Bottom Total Depth of Well 4825
Show depth and thickness of all water, oil and gas formations.

OIL, GAS OR WATER RECORDS

CASING RECORD

FORMATION	CONTENT	FROM	TO	SIZE	PUT IN	PULLED OUT
	Surface					
	Casing	0	238	8 5/8"	238'	none

Describe in detail the manner in which the well was plugged, indicating where the mud fluid
was placed and the method or methods used in introducing it into the hold. If cement or other
plugs were used, state the character of same and depth placed, from feet to
feet for each plug set.

Plug with 30 sacks cement at 240',
plug with 12 sacks cement at 40'
3 sacks in rat hole. Plug down
at 4:30 P.M. January 27, 1978.

RECEIVED
STATE CORPORATION COMMISSION

FEB 01 1978

CONSERVATION DIVISION
Wichita, Kansas

(If additional description is necessary, use BACK of this sheet)

Name of Plugging Contractor Search Drilling Company

STATE OF Kansas COUNTY OF Sedgwick, ss.
R. M. Stagl (employee of owner) or (owner or operator)
of the above-described well, being first duly sworn on oath, says: That I have knowledge of
the facts, statements, and matters herein contained and the log of the above-described well
as filed and that the same are true and correct. So help me God.

(Signature) R. M. Stagl
Wichita, Kansas

(Address)

SUBSCRIBED AND SWORN TO before me this 30th day of January, 1978

Maxine Dressen
Notary Public.

My commission expires February 22, 1981



DRILLERS LOG

MOOTS #1

CASING RECORD:
8 5/8" set at 238'
with 250 sacks cement

OPERATOR: Patrick Petroleum Corporatin

DESCRIPTION:

CONTRACTOR: Search Drilling Company

C SW SW
Section 34-32S-12W
Barber County,
Kansas

TOTAL DEPTH:

COMMENCED: January 17, 1978

4825'

COMPLETED: January 27, 1978

FORMATION	FROM	TO	REMARKS
Red Bed and Shale	0	250	
Shale and Lime	250	371	
Shale	371	1599	
Anhydrite	1599	1612	
Lime and Shale	1612	1800	
Lime and Shale	1800	1920	
Lime and Shale	1920	2388	
Lime and Shale	2388	3208	
Lime and Shale	3208	3967	
Lime and Shale	3967	4417	
Lime and Shale (Mississippi)	4417	4450	
Lime and Shale	4450	4495	
Lime and Shale	4495	4800	
Lime and Shale	4800	4816	
Lime and Shale	4816	4825	
Total Rotary Depth	4825		Dry and Abandoned

RECEIVED
STATE CORPORATION COMMISSION
FEB 01 1978
CONSERVATION DIVISION
Wichita, Kansas

I certify that this is a true and correct copy of the above log to the best of my knowledge.

SEARCH DRILLING COMPANY

R. M. Stagl
R. M. Stagl

Subscribed and sworn to before me this 30th day of January, 1978

Maxine Dressen
Maxine Dressen Notary Public

My appointment expires:
February 22, 1981

