

CARD MUST BE TYPED

State of Kansas
NOTICE OF INTENTION TO DRILL

CARD MUST BE SIGNED

(see rules on reverse side)

Starting Date: May 3 1985
month day year

API Number 15- 007-22,039-00-00

OPERATOR: License # 5316
Name Falcon Exploration, Inc.
Address Suite 1531 KSB Building
City/State/Zip Wichita, Kansas 67202
Contact Person Mike Mitchell
Phone (316) 262-1378

S/2 SE/4 SE/4 Sec 36, Twp 31 S, Rge 12
(location) East West

330 Ft North from Southeast Corner of Section
660 Ft West from Southeast Corner of Section
(Note: Locate well on Section Plat on reverse side)

CONTRACTOR: License # 5302
Name Red Tiger Drilling Co.
City/State Wichita, Kansas

Nearest lease or unit boundary line 330 feet
County Barber
Lease Name Smith-Slamal Well# 1

Domestic well within 330 feet: yes no
Municipal well within one mile: yes no

Well Drilled For: Well Class: Type Equipment:
 Oil Swd Infield Mud Rotary
 Gas Inj Pool Ext. Air Rotary
 OWWO Expl Wildcat Cable

Depth to Bottom of fresh water 65 feet
Lowest usable water formation
Depth to Bottom of usable water 200 feet
Surface pipe by Alternate: 1 2
Surface pipe to be set 250 feet
Conductor pipe if any required
Ground surface elevation feet MSI
This Authorization Expires 11-3-85
Approved By 5-3-85

If OWWO: old well info as follows:
Operator
Well Name
Comp Date Old Total Depth
Projected Total Depth 4400 feet
Projected Formation at TD Mississippi
Expected Producing Formations Mississippi

I certify that we will comply with K.S.A. 55-101, et seq., plus eventually plugging hole to K.C.C. specifications.

Date 4-24-85 Signature of Operator or Agent


W. D. S. Lutz, Jr. Title President

MHC / LDH 5-3-85 Form C-1 4/84

Must be filed with the K.C.C. five (5) days prior to commencing well
This form void if drilling not started within six (6) months of date received by K.C.C.
KANSAS
CONSERVATION DIVISION

MAY 3 1985

STATE CORPORATION COMMISSION
A Regular Section of Land
1 Mile = 5,280 Ft.

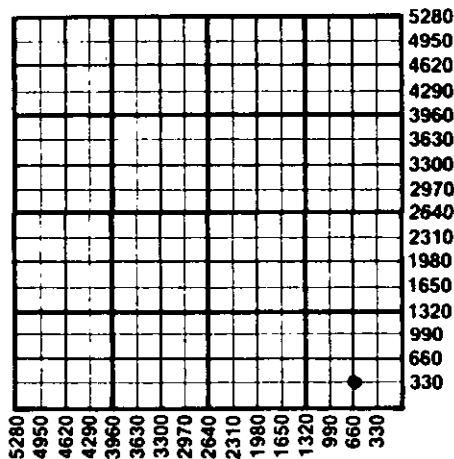

Important procedures to follow :

1. Notify District office before setting surface casing.
2. Set surface casing by circulating cement to the top.
3. File completion forms ACO-1 with K.C.C. within 90 days of well completion, following instructions on ACO-1, side 1, and including copies of wireline logs.
4. Notify District office 48 hours prior to old well workover or re-entry.
5. Prior to plugging, prepare a plugging plan, then obtain agreement from the appropriate district office for an approved plugging plan.
6. Submit plugging report (CP-4) to K.C.C. after plugging is completed.
7. Obtain an approved injection docket number before disposing of salt water.
8. Notify K.C.C. within 10 days when injection commences or terminates.
9. If an alternate 2 completion, cement in the production pipe from below any usable water to surface within 120 days of spud date.

State Corporation Commission of Kansas
Conservation Division
200 Colorado Derby Building
Wichita, Kansas 67202
(316) 263-3238