

FOR KCC USE:

EFFECTIVE DATE: 12-18-91

DISTRICT # 1

SEAF. X Yes No

FORM C-1 7/91

FORM MUST BE TYPED

FORM MUST BE SIGNED

ALL BLANKS MUST BE FILLED

State of Kansas  
NOTICE OF INTENTION TO DRILL

Must be approved by the K.C.C. five (5) days prior to commencing well

Expected Spud Date December 13, 1991  
month day year

Spot 5' N of  
C-W/2 - NE - SE Sec 9 Twp 30 S. Rg 13 X West

OPERATOR: License # 5506  
Name: WOOLSEY PETROLEUM CORPORATION  
Address: 107 North Market - Suite 600  
City/State/Zip: Wichita, Kansas 67202-1807  
Contact Person: J. Wayne Woolsey  
Phone: 316/26704379

1985 feet from South / ~~XXXX~~ line of Section  
990 feet from East / ~~XXXX~~ line of Section  
IS SECTION REGULAR X IRREGULAR?

CONTRACTOR: License #: 5929  
Name: DUKE DRILLING CO., INC.

(NOTE: Locate well on the Section Plat on Reverse Side)  
County: Barber  
Lease Name: Lawrenz Well #: 1 TWIN  
Field Name: JEM South

Well Drilled For: Well Class: Type Equipment:  
X Oil ... Enh Rec ..X Infield X Mud Rotary  
... Gas ... Storage ... Pool Ext. ... Air Rotary  
... OUVO ... Disposal ... Wildcat ... Cable  
... Seismic: ... # of Holes ... Other

Is this a Prorated/Spaced Field? .. yes ..X no  
Target Formation(s): Arbuckle  
Nearest lease or unit boundary: 330'  
Ground Surface Elevation: 1846' feet MSL

If OUVO: old well information as follows:  
Operator: .....  
Well Name: .....  
Comp. Date: ..... Old Total Depth .....

Water well within one-quarter mile: ... yes ..X no  
Public water supply well within one mile: ... yes ..X no  
Depth to bottom of fresh water: 150'  
Depth to bottom of usable water: 180'

Directional, Deviated or Horizontal wellbore? .... yes ..X no  
If yes, true vertical depth: .....  
Bottom Hole Location: .....

Surface Pipe by Alternate: X 1 ..... 2  
Length of Surface Pipe Planned to be set: 1000'  
Length of Conductor pipe required: N/A (plan 100')  
Projected Total Depth: 4750'

Formation at Total Depth: Arbuckle  
Water Source for Drilling Operations:  
... well .... farm pond X .. other

DVR Permit #: .....  
Will Cores Be Taken?: ... yes ..X no  
If yes, proposed zone: .....

AFFIDAVIT

The undersigned hereby affirms that the drilling, completion and eventual plugging of this well will comply with K.S.A. 55-101, et. seq.

It is agreed that the following minimum requirements will be met:

1. Notify the appropriate district office prior to spudding of well;
2. A copy of the approved notice of intent to drill shall be posted on each drilling rig;
3. The minimum amount of surface pipe as specified below shall be set by circulating cement to the top; in all cases surface pipe shall be set through all unconsolidated materials plus a minimum of 20 feet into the underlying formation;
4. If the well is dry hole, an agreement between the operator and the district office on plug length and placement is necessary prior to plugging;
5. The appropriate district office will be notified before well is either plugged or production casing is cemented in;
6. IF AN ALTERNATE II COMPLETION, PRODUCTION PIPE SHALL BE CEMENTED FROM BELOW ANY USABLE WATER TO SURFACE WITHIN 120 DAYS OF SPUD DATE. IN ALL CASES, NOTIFY DISTRICT OFFICE PRIOR TO ANY CEMENTING.

I hereby certify that the statements made herein are true and to the best of my knowledge and belief.

Date: 12/13/91 Signature of Operator or Agent: Sally J. Dyers Title: Agent

FOR KCC USE:  
API # 15- 007-22388-00-00  
Conductor pipe required None feet  
Minimum surface pipe required 200 feet per Alt. ①  
Approved by: MWD 12-13-91

This authorization expires: 6-13-92  
(This authorization void if drilling not started within 6 months of effective date.)  
Spud date: \_\_\_\_\_ Agent: \_\_\_\_\_

CONTACT DISTRICT OFFICE PRIOR TO SPUDDING FOR APPROVAL

RECEIVED  
KANSAS CORPORATION COMMISSION  
DEC 13 1991  
CONSERVATION DIVISION  
WICHITA, KS

9  
30  
1360

REMEMBER TO:

- 1. File Drill Pit Application (form CDP-1) with Intent to Drill;
  - 2. File Completion Form ACO-1 within 120 days of spud date;
  - 3. Increase attribution plat according to field proration orders;
  - 4. Notify appropriate district office 48 hours prior to workover or re-entry;
  - 5. Submit plugging report (CP-4) after plugging is completed;
  - 6. Obtain written approval before disposing or injecting salt water.
- Conservation Division, 200 Colorado Derby Building, 202 W. First St., Wichita, Kansas 67202-1286.

W 3:00 PM D

CT 12-13-91

men

IN ALL CASES PLOT THE INTENDED WELL ON THE PLAT BELOW

PLAT OF ACREAGE ATTRIBUTABLE TO A WELL IN A PRORATED OR SPACED FIELD

If the intended well is in a prorated or spaced field, please fully complete this side of the form. If the intended well is in a prorated or spaced field complete the plat below showing that the well will be properly located in relationship to other wells producing from the common source of supply. Please show all the wells within 1 mile of the boundaries of the proposed acreage attribution unit for gas wells and within 1/2 mile of the boundaries of the proposed acreage attribution unit for oil wells.

API NO. 15- \_\_\_\_\_  
 OPERATOR \_\_\_\_\_  
 LEASE \_\_\_\_\_  
 WELL NUMBER \_\_\_\_\_  
 FIELD \_\_\_\_\_



LOCATION OF WELL: COUNTY \_\_\_\_\_  
 \_\_\_\_\_ feet from south/north line of section  
 \_\_\_\_\_ feet from east/west line of section  
 SECTION \_\_\_\_\_ TWP \_\_\_\_\_ RC \_\_\_\_\_

NUMBER OF ACRES ATTRIBUTABLE TO WELL \_\_\_\_\_  
 QTR/QTR/QTR OF ACREAGE \_\_\_\_\_

IS SECTION \_\_\_\_\_ REGULAR or \_\_\_\_\_ IRREGULAR  
IF SECTION IS IRREGULAR, LOCATE WELL FROM NEAREST CORNER BOUNDARY.

Section corner used: \_\_\_\_\_ NE \_\_\_\_\_ NW \_\_\_\_\_ SE \_\_\_\_\_ SW  
PLAT

(Show location of the well and shade attributable acreage for prorated or spaced wells.)  
 (Show footage to the nearest lease or unit boundary line.)

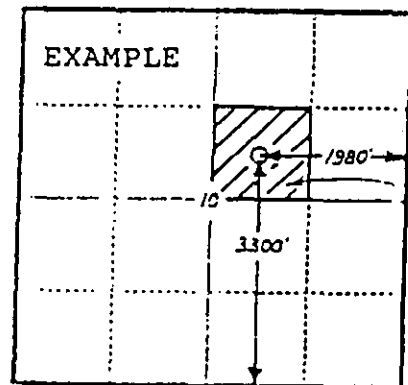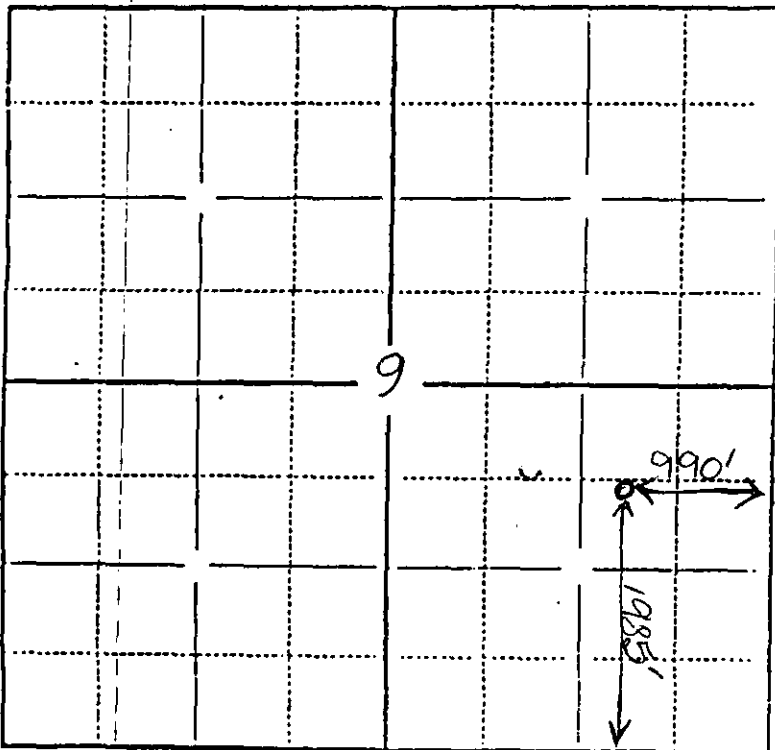

SEWARD CO.

40  
ACRES

In plotting the proposed location of the well, you must show:

- 1) The manner in which you are using the depicted plat by identifying section lines, i.e. 1 section, 1 section with 8 surrounding sections, 4 sections.
- 2) the distance of the proposed drilling location from the section's south/north and east/west lines; and
- 3) the distance to the nearest lease or unit boundary line.

14  
 FOR APPROVAL  
 TO SPENDING  
 OFFICE ONLY  
 \_\_\_\_\_ W  
 \_\_\_\_\_ TO