

This form shall be filed in duplicate with the Kansas Corporation Commission, 200 Colorado Derby Building, Wichita, Kansas 67202, within ten days after the completion of the well, regardless of how the well was completed.

Attach separate letter of request if the information is to be held confidential. If confidential, only file one copy. Information on side one will be of public record and side two will then be held confidential.

Circle one: Oil, Gas, Dry, SWD, OWWO, Injection. Type and complete ALL sections. Applications must be filed for dual completion, commingling, SWD and injection.

Attach wireline logs (i.e. electrical log, sonic log, gamma ray neutron log, etc.). KCC # (316) 263-3238. (Rules 82-2-105 & 82-2-125)

OPERATOR Rupe Oil Company, Inc.

API NO. 15-007-21,191-00-00

ADDRESS P. O. Box 2273

COUNTY Barber

Wichita, Kansas 67201

FIELD Lulu

**CONTACT PERSON William G. Clement

PROD. FORMATION None

PHONE 262-3748

LEASE DOUTHETT

PURCHASER -----

WELL NO. 1

ADDRESS -----

WELL LOCATION C SW SW

DRILLING Contractor Landmark Energy Corporation

660 Ft. from West Line and

CONTRACTOR

660 Ft. from South Line of

ADDRESS Box 18595

the SW/4 SEC. 24 TWP. 30S RGE. 11W

Wichita, Kansas 67218

WELL PLAT

PLUGGING Contractor Halliburton

CONTRACTOR

ADDRESS P. O. Box 963


Pratt, Kansas 67124

TOTAL DEPTH 4885 RTD PBTD None

SPUD DATE 11-24-81 DATE COMPLETED 12-9-81

ELEV: GR 1785 DF 1788 KB 1790

DRILLED WITH (CABLE) (ROTARY) (AIR) TOOLS

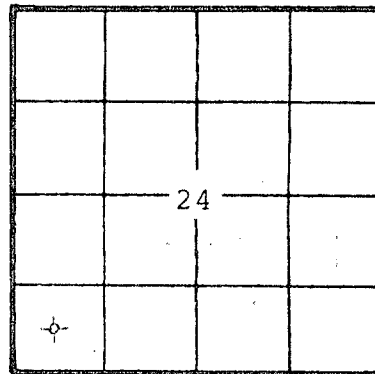

KCC [check]
KGS [check]
(Office Use)

Amount of surface pipe set and cemented 280 feet

DV Tool Used? NO

AFFIDAVIT

STATE OF KANSAS, COUNTY OF SEDGWICK

Tetrick Kopper OF LAWFUL AGE, BEING FIRST DULY SWORN UPON

DEPOSES THAT SHE IS Geologist (FOR)(OF) Rupe Oil Company, Inc.

OPERATOR OF THE Douthett LEASE, AND IS DULY AUTHORIZED TO MAKE

THIS AFFIDAVIT FOR AND ON THE BEHALF OF SAID OPERATOR, THAT WELL NO. 1 ON

SAID LEASE HAS BEEN COMPLETED AS OF THE 9th DAY OF December, 19 81, AND THAT

ALL INFORMATION ENTERED HEREIN WITH RESPECT TO SAID WELL IS TRUE AND CORRECT.

FURTHER AFFIANT SAITH NOT.

SUBSCRIBED AND SWORN BEFORE ME THIS 16th DAY OF December, 19 81

(S) Martha Tetrick Kopper
Martha Tetrick Kopper

Mildred A. Fisher
NOTARY PUBLIC
Mildred A. Fisher

MY COMMISSION EXPIRES: February 1, 1981

**The person who can be reached by phone regarding any questions concerning this information. Within 45 days of completion, a witnessed initial test by the Commission is required if the well produces more than 25 BOPD or is located in a Basic Order Pool.

RECEIVED
STATE CORPORATION COMMISSION
DEC 17 1981
CONSERVATION DIVISION
Wichita, Kansas

