


Give All Information Completely
Make Required Affidavit
Mail or Deliver Report to:
Conservation Division
State Corporation Commission
211 No. Broadway
Wichita, Kansas

WELL PLUGGING RECORD

T 34S NORTH R 13W

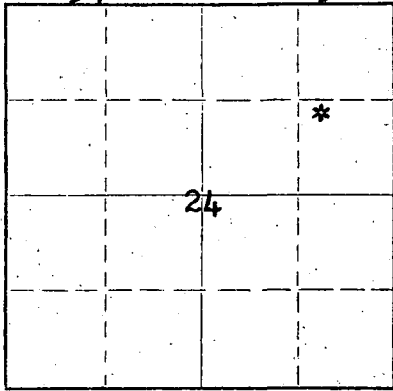

Locate well correctly on above Section Plat

Barber County, Sec. 24 Twp. 34S Rge. 13W (E) (W)
Location as "NE/CNW/SW" or footage from lines NW SEVNE
Lease Owner The Carter Oil Company
Lease Name R. B. Cook Well No. 3
Office Address Box 801 - Tulsa, Oklahoma
Character of Well (completed as Oil, Gas or Dry Hole) Dryhole
Date well completed May 22, 19 56
Application for plugging filed May 29, 19 56
Application for plugging approved April 1, 19 56
Plugging commenced July 12, 19 56
Plugging completed July 16, 19 56
Reason for abandonment of well or producing formation Uneconomical to operate

If a producing well is abandoned, date of last production -0- 19
Was permission obtained from the Conservation Division or its agents before plugging was commenced? Yes

Name of Conservation Agent who supervised plugging of this well Merle Rives
Producing formation - Depth to top - Bottom - Total Depth of Well 4905 Feet
Show depth and thickness of all water, oil and gas formations.

OIL, GAS OR WATER RECORDS

CASING RECORD

FORMATION	CONTENT	FROM	TO	SIZE	PUT IN	PULLED OUT
				8-5/8"	250'	None
				5-1/2"	4905'	4175'

Describe in detail the manner in which the well was plugged, indicating where the mud fluid was placed and the method or methods used in introducing it into the hole. If cement or other plugs were used, state the character of same and depth placed, from _____ feet to _____ feet for each plug set.

Knocked bridge from 4125' to 4175' and after pulling casing up to 1800' circulated the hole with 24 sacks of jell mud. Bailed the hole to 250', set a rock bridge to 245' and ran 20 sacks of cement. Cement filled to 175'. Mudded the hole to 20', set a 5' rock bridge and ran 10 sacks of cement which filled to base of cellar. Plugging completed.

(If additional description is necessary, use BACK of this sheet)
Name of Plugging Contractor West Supply Co., Inc.
Address Chase, Kansas

STATE OF KANSAS, COUNTY OF BARTON, ss.
Hugh H. Goerner (employee of owner) or (owner or operator) of the above-described well, being first duly sworn on oath, says: That I have knowledge of the facts, statements, and matters herein contained and the log of the above-described well as filed and that the same are true and correct. So help me God.

(Signature) _____
District Superintendent
Box 786, Great Bend, Kansas
(Address)

SUBSCRIBED AND SWORN TO before me this 20th day of August, 19 56

My commission expires August 19, 1957

W. N. Kinsley
STATE CORPORATION COMMISSION Notary Public.

AUG 22 1956

CONSERVATION DIVISION
Wichita, Kansas

PLUGGING
FILE SEC. 24 T. 34 R. 13W
BOOK PAGE 66 LINE 24

NO. 3 R. B. COOK

WELL LOG

Location: NW SE NE, 24-34S-13W
Barber County, Kansas

Commenced: April 10, 1956

Operator: Carter Oil Company
P. O. Box 2895, Wichita, Kansas

Completed: April 30, 1956

Elevation: 1582 KB (1577 Gr)

Contractor: Graham-Messman-Rinehart Drilling Co.
1005 East Second, Wichita, Kansas

Production:

Casing Record: 8 5/8" @ 250' w/275 sacks cement
5 1/2" @ 4902' w/200 sacks cement

.....L O G.....

Red Bed-Sand	255		
Red Bed	1247		
Shale-Lime	1943		
Lime	2041		
Lime-Shale	2886		
Shale-Lime	3167		
Lime-Shale	3266		
Shale-Lime	3591		
Lime-Shale	3818		
Shale-Lime	3892		
Lime-Shale	4106		
Lime	4239		
Lime-Shale	4277		
Lime	4795		
Sand-Lime	4814		
Core #1	4839		
Core #2	4860		
Lime	4881		
Lime-Chert	4899		
Miss. Chert and Lime	4905	R.T.D.	Mississippi 4810 (-3228)

The undersigned, GRAHAM-MESSMAN-RINEHART DRILLING COMPANY, hereby certifies that the above log is a true and correct log of the formation encountered in drilling the above well as reflected by the Daily Drilling Report.

GRAHAM-MESSMAN-RINEHART DRILLING COMPANY

By: J. A. Gilliland
J. A. Gilliland

Subscribed and sworn to before me this 3rd day of May, 1956.

Martha L. Lewis
Notary Public

My Commission Expires: November 5, 1958

PLUGGING
FILE SEC 24 T. 34 R. 13W
BOOK PAGE 66 LINE 24

RECEIVED
STATE CORPORATION COMMISSION
MAY 30 1956
CONSERVATION DIVISION
Wichita, Kansas