


STATE OF KANSAS
STATE CORPORATION COMMISSION

Form CP-4

Give All Information Completely.
Make Required Affidavit
Mail or Deliver Report to:
Conservation Division
State Corporation Commission
212 No. Market
Wichita, Kansas 67202

WELL PLUGGING RECORD

Barber County, Sec. 25 Twp. 34S Rge. 13W (E) (W)
Location as "NE/CNW/SE/SW" or footage from lines. 990' From South and East line
Lease Owner Atlantic-Richfield Co. SE 1/4
Lease Name Edd Sterling Well No. 1
Office Address Box 849 Great Bend, Kansas 67530
Character of Well (completed as Oil, Gas or Dry Hole) Oil and Gas
Date well completed Nov. 7, 1955 19 55
Application for plugging filed May 16, 19 74
Application for plugging approved May 20, 19 74
Plugging commenced May 20, 19 74
Plugging completed May 28, 19 74
Reason for abandonment of well or producing formation Not commercial

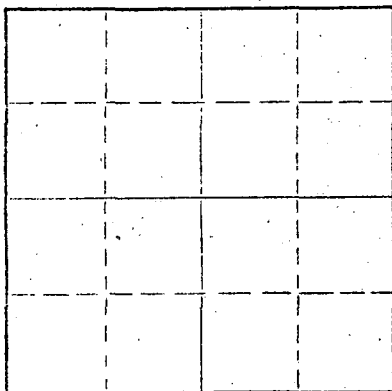

Locate well correctly on above Section Plat

If a producing well is abandoned, date of last production May 18, 19 74
Was permission obtained from the Conservation Division or its agents before plugging was commenced? Yes

Name of Conservation Agent who supervised plugging of this well Russell Biberstien
Producing formation Miss. Depth to top Bottom Total Depth of Well 4,920 Feet
Show depth and thickness of all water, oil and gas formations.

OIL, GAS OR WATER RECORDS

CASING RECORD

FORMATION	CONTENT	FROM	TO	SIZE	PUT IN	PULLED OUT
				10 3/4	273	None
				5 1/2"	4,916	3,281

Describe in detail the manner in which the well was plugged, indicating where the mud fluid was placed and the method or methods used in introducing it into the hole. If cement or other plugs were used, state the character of same and depth placed, from _____ feet to _____ feet for each plug set.

Dump sand. From 4,891 To 4,800
5 Sacks cement with Dump Bailer From 4,800 To 4,765
Ripped pipe at 3,481 and 3,281
Wood Bridge at 200'. Rock from 200' To 190'.
5 Yards of Ready Mix.

RECEIVED
STATE CORPORATION COMMISSION
JUN 3 1974
CONSERVATION DIVISION
Wichita, Kansas

(If additional description is necessary, use BACK of this sheet)


Name of Plugging Contractor Clarke Corporation
Address Box 187 Medicine Lodge, Kansas 67104

STATE OF Kansas, COUNTY OF Barber, ss.
_____, (employee of owner) or (owner or operator) of the above-described well, being first duly sworn on oath, says: That I have knowledge of the facts, statements, and matters herein contained and the log of the above-described well as filed and that the same are true and correct. So help me God.

(Signature) Edd Sterling
Medicine Lodge, Kansas
(Address)

Subscribed and sworn to before me this 30th day of May, 1974

Notary Public.

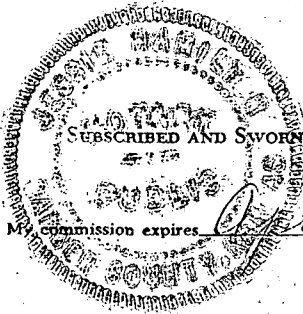

SCREEN SETTING REPORT

None

KIND AND NUMBER OF SCRATCHERS USED None

KIND AND NUMBER OF CENTRALIZERS USED None

PACKER SET AT 1792 FEET DATE SET 11-14-55 SIZE AND KIND OF PACKER Packer Model 15 Washers

DRILL STEM TESTS

DATE	PACKER SET AT DEPTH	FORMATION		SIZE CHOKE		TOOL-OPEN MIN.	FORMATION PRES.		RECOVERY - FEET				WAS TEST SATIS.
		FROM	TO	TOP	BOTTOM		FLOWING	SHUT-IN	OIL	WATER	MUD	OTHER	
11-14-55	1792'	1792	1804	1"	5/8"	120	18 to 18	1862	25'	97'			Yes
11-7-55	1809'	1809	1859	1"	5/8"	120	100 to 100	1835		20'			Yes

WAS ANY JUNK EQUIPMENT TOOLS OR PIPE LEFT IN HOLE AT COMPLETION OF DRILLING? No

REMARKS: After mud acid job swabbed total load of 32 bbls. in 6 hrs.
After acid petrolfree job swabbed 162 bbls. load oil & acid water in 12 hrs.
Swabbed 127 bbls. load oil and acid water in 2 1/2 hrs. Flowed 51 bbls. load oil &
acid water in 2 1/2 hrs. Flowed 24 bbls. load oil & acid water in 2 1/2 hrs. Failed to
recover 121 bbls. load oil and acid water.

PLUGBACK AND PLUGGING RECORD

APPROVED:

DATE	TYPE PLUG	FROM	TO
11-15-55	Cement	4920'	4891'

M. B. Weeks
 DISTRICT SUPERINTENDENT
 DIVISION SUPERINTENDENT
 ENGINEER-GEOLOGIST

(SHOW ALL MEASUREMENTS FROM SURFACE LEVEL)

FORMATION	DEPTH TO TOP	SUB SEA ELEV.	FORMATION	DEPTH TO TOP	SUB SEA ELEV.
Elgin	3694	-2114			
Poolner	3858	-2368			
Toronto	3888	-2398			
Bottom Douglas	3926	-2436			
Lansing	4066	-2576			
Marston	4656	-3166			
Burgess	4765	-3275			
Mississippi	4804	-3314			

RECEIVED
 STATE CORPORATION COMMISSION
 MAY 17 1974
 CONSERVATION DIVISION
 Wichita, Kansas