

15-007-21175-00-00

STATE OF KANSAS  
STATE CORPORATION COMMISSION

WELL PLUGGING RECORD

Give All Information Completely  
Make Required Affidavit.  
Mail or Deliver Report to  
Conservation Division  
State Corporation Comm.  
245 North Water  
Wichita, KS 67202

Barber County. Sec. 23 Twp. 34S Rge. 13W E/W  
Location as "NE/CNW $\frac{1}{4}$ SW $\frac{1}{4}$ " or footage from lines  
E/2 SE SE


Lease Owner Pickrell Drilling Company  
Lease Name Allen 'C' Well No. 1  
Office Address 110 N. Market, Suite 205, Wichita, KS 67202  
Character of Well (Completed as Oil, Gas or Dry Hole)

Dry Hole  
Date Well completed 5-20 1981  
Application for plugging filed 5-20 1981  
Application for plugging approved 5-20 1981  
Plugging commenced 5-20 1981  
Plugging completed 5-20 1981

Reason for abandonment of well or producing formation  
Dry Hole  
If a producing well is abandoned, date of last production 19

Was permission obtained from the Conservation Division or  
its agents before plugging was commenced? Yes

Name of Conservation Agent who supervised plugging of this well Maurice Leslie  
Producing formation Depth to top Bottom Total Depth of Well 4845'  
Show depth and thickness of all water, oil and gas formations.

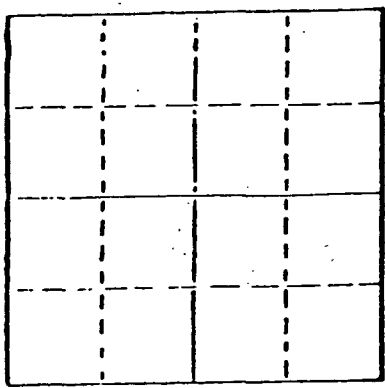

Locate well correctly on above  
Section Plat

OIL, GAS OR WATER RECORDS

CASING RECORD

FORMATION	CONTENT	FROM	TO	SIZE	PUT IN	PULLED OUT
				8 5/8"	264' KB	None

Describe in detail the manner in which the well was plugged, indicating where the mud fluid was placed and the method or methods used in introducing it into the hold. If cement or other plugs were used, state the character of same and depth placed, from feet to feet for each plug set.

60 sx at 250'  
10 sx at 40' with solid bridge plug  
10 sx rathole, completed 10:30 p.m. on 5-20-81

RECEIVED  
STATE CORPORATION COMMISSION

MAY 28 1981

(If additional description is necessary, use BACK of this sheet)


Name of Plugging Contractor Pickrell Drilling Company  
Wichita, Kansas

STATE OF Kansas COUNTY OF Sedgwick, ss.  
C. W. Sebitts (employee of owner) or (owner or operator)

of the above-described well, being first duly sworn on oath, says: That I have knowledge of the facts, statements, and matters herein contained and the log of the above-described well as filed and that the same are true and correct. So help me God.

(Signature) [Handwritten Signature]  
110 N. Market, Suite 205, Wichita, KS 67202  
(Address)

SUBSCRIBED AND SWORN TO before me this 27th day of May, 1981

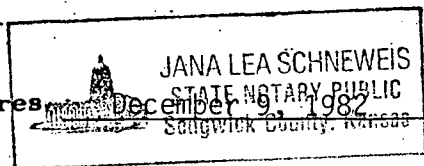

Jana Lea Schneeweis  
Notary Public.

**ROTARY DRILLING LOG**

COMPANY: Pickrell Drilling Company  
205 Litwin Building, 110 North Market  
Wichita, Kansas 67202

Rotary Drilling Commenced 5-11-81

Rotary Drilling Completed 5-20-81

LOCATION: #1 Allen 'C'  
E/2 SE SE, Sec. 23-34S-13W  
Barber County, Kansas

CONTRACTOR: **PICKRELL DRILLING COMPANY**  
Wichita, Kansas

CASING RECORD: Spud 5-11-81, surface pipe 8 5/8", depth 264' KB, cement 250 sx.

**LOG**

(Figures indicate bottom of formation — measurements from top of rotary bushing.)

Top Soil	40
Red Beds	270
Shale	1500
Shale & Lime	1970
Lime & Shale	4790
Lime	4845

RECEIVED  
STATE CORPORATION COMMISSION

MAY 28 1981

CONSERVATION DIVISION  
Wichita, Kansas

The undersigned, C. W. Sebitts, Attorney-in-Fact for PICKRELL DRILLING COMPANY, hereby certifies in behalf of said Company, that the above is a true and correct log of the formation encountered in drilling the above well as reflected by the Daily Drilling Reports.

PICKRELL DRILLING COMPANY


By C. W. Sebitts Attorney-in-Fact

STATE OF KANSAS }  
COUNTY OF SEDGWICK } ss.:

On this 27th day of May, 1981, before me the undersigned, a Notary Public, in and for the County and State aforesaid, personally appeared C. W. Sebitts, to me known to be the identical person who subscribed the name of PICKRELL DRILLING COMPANY to the foregoing instrument as its Attorney-in-Fact and acknowledged to me that he executed the same as his free and voluntary act and deed, and as the free and voluntary act and deed of such company, for the uses and purposes therein set forth.

Given under my hand and seal of office the day and year last above written.

My commission expires:

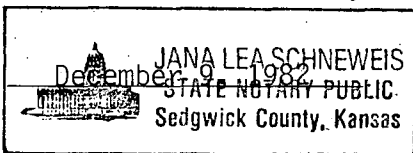

Jana Lea Schneeweis  
Notary Public