


WELL PLUGGING RECORD

Give All Information Completely
Make Required Affidavit
Mail or Deliver Report to:
Conservation Division
State Corporation Commission
800 Bitting Building
Wichita, Kansas

NORTH

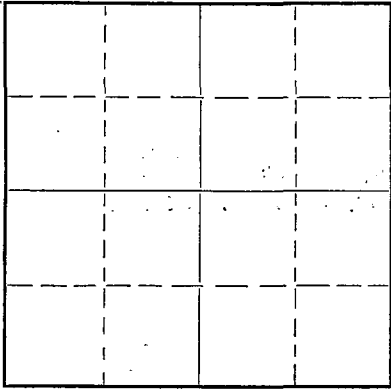

Locate well correctly on above
Section Plat

Barber County. Sec. 10 Twp. 31S Rge. 11 (E) W (W)
Location as "NE/CNW 1/4 SW 1/4" or footage from lines NE NE NE
Lease Owner Rine & Gore
Lease Name Bergner Well No. 1
Office Address 320 Central Bldg., Wichita 2, Kansas
Character of Well (completed as Oil, Gas or Dry Hole) Dry Hole
Date well completed July 15, 1950 19
Application for plugging filed July 15, 1950 19
Application for plugging approved July 15, 1950 19
Plugging commenced July 15, 1950 2:00 P.M. 19
Plugging completed July 15, 1950 4:00 P.M. 19
Reason for abandonment of well or producing formation

Dry Hole

If a producing well is abandoned, date of last production 19
Was permission obtained from the Conservation Division or its agents before plugging was commenced? Yes. Via telephone/

Name of Conservation Agent who supervised plugging of this well S. S. Greider
Producing formation None Depth to top Bottom Total Depth of Well 5017 Feet
Show depth and thickness of all water, oil and gas formations.

OIL, GAS OR WATER RECORDS

CASING RECORD

Formation	Content	From	To	Size	Put In	Pulled Out
Surface	Sand	0	155			
Red Rock	Same	155	356	8-5/8	356	None

Describe in detail the manner in which the well was plugged, indicating where the mud fluid was placed and the method or methods used in introducing it into the hole. If cement or other plugs were used, state the character of same and depth placed, from feet to feet for each plug set.

Heavy mud from total depth to 300'
Wood plug and 15 sacks cement @ 300'
Heavy mud from plug @ 300' to 20'
Plug and 5 sacks cement @ 20' filling casing to base of cellar.

(If additional description is necessary, use BACK of this sheet)

Correspondence regarding this well should be addressed to R. W. Rine Drilling Company, 320 Central Bldg., Wichita 2, Kansas

STATE OF Kansas, COUNTY OF Sedgwick, ss.

E. H. Sloyer (employee of owner) or (owner or operator) of the above-described well, being first duly sworn on oath, says: That I have knowledge of the facts, statements, and matters herein contained and the log of the above-described well as filed and that the same are true and correct. So help me God. THE R. W. RINE DRILLING COMPANY

(Signature) By: E. H. Sloyer
320 Central Bldg., Wichita 2, Kansas (Address)

SUBSCRIBED AND SWORN to before me this 15th day of July 1950

Conservation Div. Notary Public.

My commission expires Dec. 29, 1952

PLUGGING
FILE SEC 10 T 31 R 11W
BOOK PAGE 16 LINE 27

STATE CORPORATION COMMISSION
JUL 20 1950

15-007-00341-0000

Bergner Well No. 1

NE NE NE
Sec. 10-31S-11W
Barber County
Kansas

Contractor: The R. W. Rine Drilling Company
Started: 6/23/50 Finished: 7/14/50

Log

Surface	0 = 40	
Sand	40 = 155	
Red bed & rock	155 = 356	
Red bed shale, shells	356 = 810	
Shale & shells	810 = 1600	Syfo @ 1500' O.K.
Shale & salt	1600 = 1690	
Shale & lime	1690 = 1915	
Lime	1915 = 2085	Syfo @ 2000' O.K.
Lime & shale	2085 = 2340	
Sandy lime	2340 = 2420	
Shale	2420 = 2465	
Shale & lime	2465 = 3125	Syfo @ 2500' O.K.
Sandy lime	3125 = 3245	Syfo @ 3000' O.K.
Lime	3245 = 3450	
Lime - shale	3450 = 3905	Syfo @ 3500' O.K.
Lime	3905 = 4130	Syfo @ 4000' O.K.
Lime - shale	4130 = 4210	
Lime	4210 = 4375	
Broken Lime	4375 = 4780	
Lime	4780 = 4850	
Sand (Simpson)	4850 = 4880	Core #1 4857-72
Sand - Lime	4880 = 4925	Core #2 4872-80
Shale	4925 = 4960	
Shale - lime	4960 = 4997	
Lime (Arbuckle)	4997 = 5017	D&A

Top	K.C.L.	3930 (=2122)
	T. Mississippi	4478 (=2670)
	B. Mississippi	4589 (=2781)
	Viola	4760 (=2952)
	Simpson	4851 (=3043)
	Arbuckle	4972 (=3164)
T.D.		5015 (=3207)

State of Kansas)
County of Sedgwick) ss

I, E. H. Sloyer, do hereby certify that the above is a true and accurate log of the Bergner Well No. 1, located in the NE NE NE of Sec. 10-31S-11W, Barber County, Kansas.

E. H. Sloyer

Subscribed to and sworn before me this 18th day of July, 1950

My commission expires Dec. 29, 1952

RECEIVED

R. M. Green
Notary Public

Conservation Div.
7-10-50
JUL 20 1950

STATE CORPORATION
COMMISSION
KANSAS

PLUGGING
FILE SEC 10 T 31 R 11W
BOOK PAGE 16 LINE 27