


15-007-00717-00-81

WELL PLUGGING RECORD

Give All Information Completely
Make Required Affidavit
Mail or Deliver Report to:
Conservation Division
State Corporation Commission
211 No. Broadway
Wichita, Kansas

Barber County, Sec. 9 Twp. 31S Rge. 11W (E) (W)

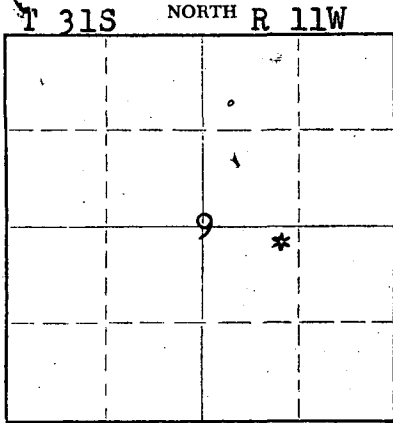

Location as "NE/CNW&SW&" or footage from lines. NE NW SE
Lease Owner Carl Todd Drilling Company
Lease Name Smith Estate Well No. 1
Office Address 706-08 Union Center - Wichita, Kansas
Character of Well (completed as Oil, Gas or Dry Hole) Gas
Date well completed March 3 19 56
Application for plugging filed January 11 19 57
Application for plugging approved January 14 19 57
Plugging commenced January 14 19 57
Plugging completed January 17 19 57
Reason for abandonment of well or producing formation _____

If a producing well is abandoned, date of last production July 19 56
Was permission obtained from the Conservation Division or its agents before plugging was commenced? Yes

Name of Conservation Agent who supervised plugging of this well Merle Rives
Producing formation _____ Depth to top _____ Bottom _____ Total Depth of Well 4940 Feet
Show depth and thickness of all water, oil and gas formations.

OIL, GAS OR WATER RECORDS

CASING RECORD

FORMATION	CONTENT	FROM	TO	SIZE	PUT IN	PULLED OUT
				8-5/8"	308'	None
				4-1/2"	4940'	3743'
				Cement inside casing drilled out to 4909'. Casing perforated from 4864' to 4868'.		

Describe in detail the manner in which the well was plugged, indicating where the mud fluid was placed and the method or methods used in introducing it into the hole. If cement or other plugs were used, state the character of same and depth placed, from _____ feet to _____ feet for each plug set.

Filled the hole with sand from 4909' to 4850' and ran 3 sacks of cement. Pulled casing up to 1700' and circulated the hole with 30 sacks of jell mud. Bailed mud to 250', set a 10' rock bridge and ran 20 sacks of cement which filled to 180'. Mudded the hole to 35', set a 10' rock bridge and ran 10 sacks of cement on top. Plugging completed.

RECEIVED
STATE CORPORATION COMMISSION
FEB - 2 1957
2-2-57
CONSERVATION DIVISION
Wichita, Kansas

(If additional description is necessary, use BACK of this sheet)
Name of Plugging Contractor West Supply Co., Inc.
Address Chase, Kansas

STATE OF Kansas COUNTY OF Sedgwick, ss.
Carl Todd (employee of owner) or (owner or operator) of the above-described well, being first duly sworn on oath, says: That I have knowledge of the facts, statements, and matters herein contained and the log of the above-described well as filed and that the same are true and correct. So help me God.

(Signature) Carl Todd
706 Union Center, Wichita, Kansas
(Address)

SUBSCRIBED AND SWORN TO before me this 28th day of January, 19 57

My commission expires December 14, 1957

Martha Gray
Notary Public.

PLUGGING
FILE SEC 9 T 31 R 11W
BOOK PAGE 133 LINE 21

SMITH ESTATE #1

NE/4 NW/4 SE/4 of Section 9-31S-11W Barber County, Kansas

Rigged up Rotary Tools 2/16/56

Tore down Rotary Tools 2/20/56

Ran 181 Jts. (4933.33') 4-1/2" Pipe
set @ 4933.33'. Cemented with 125
sacks cement.

<u>FORMATION</u>	<u>FROM</u>	<u>TO</u>
Open Hole	0'	4885'
Lime, shale & sand	4885	4916
Sand & chert	4916	4940

I, Don S. Packer, do hereby certify that the foregoing log is true and correct, to the best of my knowledge and belief.



Subscribed and sworn to before me this 23rd day of February, 1956.



Notary Public

My Commission expires: July 29, 1957

PLUGGING
 FILE - SEC 9 T 31 R 11W
 BOOK PAGE 133 LINE 21

RECEIVED
STATE CONSERVATION COMMISSION

FEB 12 1957
1-12-57
CONSERVATION
Wichita