

STATE OF KANSAS
STATE CORPORATION COMMISSION


Give All Information Completely
Make Required Affidavit
Mail or Deliver Report to:
Conservation Division
State Corporation Commission
11 No. Broadway
Wichita, Kansas

WELL PLUGGING RECORD

Harper County, Sec. 4 Twp. 35S Rge. 6 KKK (W)

Location as "NE/CNW/SW" or footage from lines C SE NW
Lease Owner Kern-Landes Exploration Co., Inc.
Lease Name Schrock Well No. 1
Office Address Magnolia, Arkansas
Character of Well (completed as Oil, Gas or Dry Hole) Dry Hole
Date well completed May 22 19 64
Application for plugging filed May 25 19 64
Application for plugging approved May 22 19 64
Plugging commenced May 22 19 64
Plugging completed May 22 19 64
Reason for abandonment of well or producing formation Dry Hole

NORTH

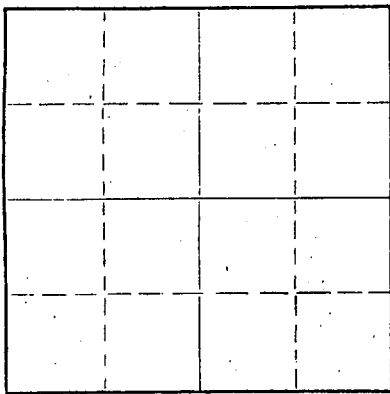

Locate well correctly on above Section Flat

If a producing well is abandoned, date of last production 19
Was permission obtained from the Conservation Division or its agents before plugging was commenced? Yes, verbally

Name of Conservation Agent who supervised plugging of this well
Producing formation Depth to top Bottom Total Depth of Well Feet
Show depth and thickness of all water, oil and gas formations.

OIL, GAS OR WATER RECORDS

CASING RECORD

FORMATION	CONTENT	FROM	TO	SIZE	PUT IN	PULLED OUT
				8-5/8"	263	

Describe in detail the manner in which the well was plugged, indicating where the mud fluid was placed and the method or methods used in introducing it into the hole. If cement or other plugs were used, state the character of same and depth placed, from feet to feet for each plug set.

Filled with heavy mud to 260'
Set first plug at 260' with 1/4 sack hulls, 25 sacks cement
Filled with heavy mud to 40'
Set second plug at 40' with 1/4 sack hulls, 10 sacks cement.
Bridged mousehole and rathole with 2 sacks cement

RECEIVED
STATE CORPORATION COMMISSION

JUN 8 1964

CONSERVATION DIVISION
Wichita, Kansas

Name of Plugging Contractor Bowers Drilling Company, Inc.
Address 416 Union Center, Wichita, Kansas

STATE OF KANSAS, COUNTY OF SEDGWICK, ss:
Emil E. Bowers (employee of owner) of the above-described well, being first duly sworn on oath, says: That I have knowledge of the facts, statements, and matters herein contained and the log of the above-described well as filed and that the same are true and correct. So help me God.

(Signature) Emil E. Bowers
416 Union Center, Wichita, Kansas (Address)

SUBSCRIBED AND SWORN to before me this 25th day of May, 19 64
May 1, 1966 Notary Public.

