

Give All Information Completely
Make Required Affidavit
Mail or Deliver Report to:
Conservation Division
State Corporation Commission
211 No. Broadway
Wichita, Kansas

WELL PLUGGING RECORD

Harper County, Sec. 8 Twp. 35 Rge. (E) 6 (W)

Location as "NE/CNW/SW" or footage from lines C SW NE

Lease Owner Kewanee Oil Company

Lease Name Miller Well No. 1

Office Address Box 2093, Wichita, Kansas

Character of Well (completed as Oil, Gas or Dry Hole) Dry Hole

Date well completed 9-21 1963

Application for plugging filed 9-21 1963

Application for plugging approved 9-21 1963


Plugging commenced 9-21 1963

Plugging completed 9-21 1963

Reason for abandonment of well or producing formation Dry Hole

If a producing well is abandoned, date of last production 19

Was permission obtained from the Conservation Division or its agents before plugging was commenced? Yes

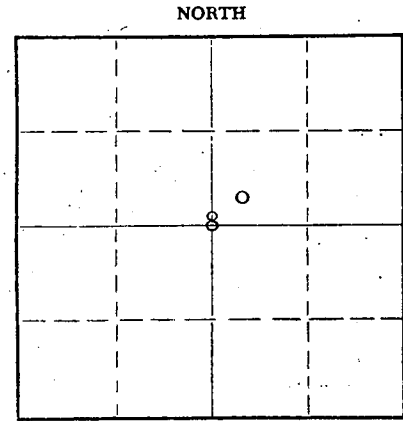

Locate well correctly on above Section Plat

Name of Conservation Agent who supervised plugging of this well Mr. Eldon Petty

Producing formation Depth to top Bottom Total Depth of Well 5204 Feet

Show depth and thickness of all water, oil and gas formations.

OIL, GAS OR WATER RECORDS

CASING RECORD

FORMATION	CONTENT	FROM	TO	SIZE	PUT IN	PULLED OUT
Simpson	Dry	0	5160	8-5/8"	488	0
		5160	5200	None	None	None

Describe in detail the manner in which the well was plugged, indicating where the mud fluid was placed and the method or methods used in introducing it into the hole. If cement or other plugs were used, state the character of same and depth placed, from feet to feet for each plug set.

- 5200' - 478' 10# mud through drill pipe
- 478' - 417' 20 sacks cement through drill pipe
- 417' - 285' 10# mud through drill pipe
- 285' - 224' 20 sacks cement through drill pipe
- 224' - 28' 10# mud through drill pipe
- 28' - Surface 10 sacks cement

RECEIVED
STATE CORPORATION COMMISSION

SEP 25 1963

CONSERVATION DIVISION
Wichita, Kansas

(If additional description is necessary, use BACK of this sheet)

Name of Plugging Contractor K & E Drilling, Inc.

Address 719 Union Center Building, Wichita, Kansas

STATE OF Kansas, COUNTY OF Sedgwick, ss. C. W. Mosier (employee of owner)

well, being first duly sworn on oath, says: That I have knowledge of the facts, statements, and matters herein contained and the log of the above-described well as filed and that the same are true and correct. So help me God.

(Signature) [Handwritten Signature]

Box 2093, Wichita, Kansas (Address)

SUBSCRIBED AND SWORN TO before me this 24th day of September, 1963

My commission expires 8-2-65

Notary Public.

KEWANEE OIL COMPANY

Well Record and Sandology: MILLER #1

Location: 660' PSL & 660' FWL of NE/4 Sec. 8-35S-6W, Harper County, Kansas

Elevation: 1285' C. M.

Drilling Contractor: K & E Drilling, Inc.

Drilling Commenced: 9-1-63

Drilling Completed: 9-21-63

Completion Date: 9-21-63

Total Depth: 5200'

Treating Record: None

Initial Production: Dry

RECEIVED
STATE CORPORATION COMMISSION

SEP 25 1963

CONSERVATION DIVISION
Wichita, Kansas

FORMATION TOPS

Elgin	3161	-1876
Heebner	3284	-1999
Toronto	3321	-2036
Stalnaker	3665	-2380
Brown Lime	3977	-2692
Layton	3994	-2709
Base Kansas City	4237	-2952
Marmaton	4308	-3023
Mississippi	4628	-3343
Kinderhook	5065	-3780
Viola	5143	-3858
Simpson	5160	-3875

CASING RECORD

8-5/8" casing cemented @ 487.93' with 425 sacks, 2% c.c.

FORMATION RECORD

0	Surface
60	Rock
876	Red rock & shale
1130	Shale
1145	Shale & lime
1528	Salt, shale & lime
2975	Lime & shale
3255	Lime
3385	Shale & lime
4647	Lime
4718	Chert & lime
5200	Lime
5200	Total Depth