


WELL PLUGGING RECORD

Give All Information Completely
Make Required Affidavit
Mail or Deliver Report to:
Conservation Division
State Corporation Commission
211 No. Broadway
Wichita, Kansas

NORTH

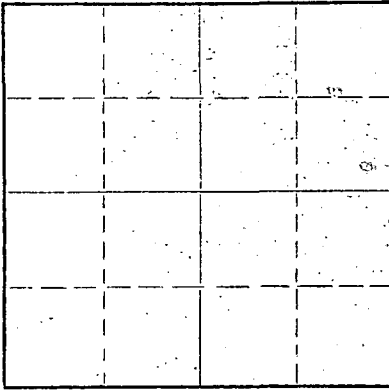

Locate well correctly on above
Section Plat

Harper County. Sec. 14 Twp. 35 Rge. 6 (E) 6 (W)
Location as "NE/CNW/SW" or footage from lines Center Lot 4
Lease Owner Jones, Shelburne & Farmer, Inc.
Lease Name LIVENGOOD Well No. 1
Office Address Russell, Kansas
Character of Well (completed as Oil, Gas or Dry Hole) Dry
Date well completed 4-30 19 56
Application for plugging filed 4-30 19 56
Application for plugging approved 4-30 19 56
Plugging commenced 4-30 19 56
Plugging completed 4-30 19 56
Reason for abandonment of well or producing formation Dry

If a producing well is abandoned, date of last production _____ 19____
Was permission obtained from the Conservation Division or its agents before plugging was commenced? Yes

Name of Conservation Agent who supervised plugging of this well M. A. Rives
Producing formation _____ Depth to top _____ Bottom _____ Total Depth of Well 5652 Feet
Show depth and thickness of all water, oil and gas formations.

OIL, GAS OR WATER RECORDS

CASING RECORD

| FORMATION | CONTENT | FROM | TO | SIZE | PUT IN | PULLED OUT |
|-----------|---------|------|----|--------|--------|------------|
| | | | | 8-5/8" | 298' | None |
| | | | | | | |
| | | | | | | |
| | | | | | | |
| | | | | | | |
| | | | | | | |
| | | | | | | |

Describe in detail the manner in which the well was plugged, indicating where the mud fluid was placed and the method or methods used in introducing it into the hole. If cement or other plugs were used, state the character of same and depth placed, from _____ feet to _____ feet for each plug set.

1. Filled hole with heavy mud
2. Pushed Halliburton Plug to 295'
3. Dumped 1/2 sacks hulls on top of plug
4. Cemented through drill pipe with 35 sacks cements
5. Filled hole to 40' from top
6. Pushed Halliburton Plug to 40'
7. Dumped 1/2 sack hulls
8. Cemented to top with 15 sacks cement.

(If additional description is necessary, use BACK of this sheet)
Name of Plugging Contractor Jones, Shelburne & Farmer, Inc.
Address Russell, Kansas

STATE OF Kansas COUNTY OF Russell, ss.
JOHN O. FARMER (employee of owner) or (owner or operator) of the above-described well, being first duly sworn on oath, says: That I have knowledge of the facts, statements, and matters herein contained and the log of the above-described well as filed and that the same are true and correct. So help me God.

(Signature) John O. Farmer
Russell, Kansas
(Address)

SUBSCRIBED AND SWORN TO before me this 7th day of May, 19 56

Lucille Kennedy
Notary Public.

My commission expires 10-11-58

PLUGGING
FILE SEC 14 T 35 R 6W
BOOK PAGE 58 LINE 36

RECEIVED
STATE CORPORATION COMMISSION
MAY 14 1956
CONSERVATION DIVISION
Wichita, Kansas

OPERATOR Jones, Shelburne & Farmer, Inc.


FORMATION RECORD

ADDRESS Russell, Kansas

Give detailed description and thickness of all formations drilled through, contents of sand, whether dry, water, oil or gas.

6
35
14
TWP
RGE
6
SEC
1
COUNTY
Harper
WELL NO
8
LIVENGOOD
FARM NAME

640 Acres
N

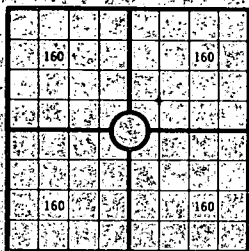

Locate well correctly

COUNTY Harper SEC 14 TWP 35 RGE 6

COMPANY OPERATING Jones, Shelburne & Farmer, Inc.

OFFICE ADDRESS Russell, Kansas

FARM NAME LIVENGOOD WELL NO 1

DRILLING STARTED 3-27-56 DRILLING FINISHED 4-30-56

DATE OF FIRST PRODUCTION _____ COMPLETED _____

WELL LOCATED Center Lot #4 North of South

Line and _____ ft East of West Line of Quarter Section

Elevation (Relative to sea level): DERRICK FLOOR 1256 GROUND 1253

CHARACTER OF WELL (Oil, gas or dryhole) Dry

OIL OR GAS SANDS OR ZONES

| Name | From | To | Name | From | To |
|------|------|----|------|------|----|
| 1 | | | | | |
| 2 | | | | | |
| 3 | | | | | |

Perforating Record If Any

Shot Record

| Formation | From | To | No. of Shots | Formation | From | To | Size of Shot |
|-----------|------|----|--------------|-----------|------|----|--------------|
| | | | | | | | |
| | | | | | | | |
| | | | | | | | |

CASING RECORD

| Amount Set | | | | Amount Pulled | | | | Packer Record | |
|------------|----|------|------|---------------|--------|-----------|------|---------------|--|
| Size | WT | Thds | Make | Size | Length | Depth Set | Make | | |
| 5/8 | | | 298 | | | | | | |
| | | | | | | | | | |
| | | | | | | | | | |

Liner Record: Amount _____ Kind _____ Top _____ Bottom _____

CEMENTING AND MUDDING

| Size | Amount Set | | Sacks Cement | Chemical | | Method of Cementing | Amount | Mudding Method | Results (See Note) |
|------|------------|----|--------------|----------|------|---------------------|--------|----------------|--------------------|
| | Ft | In | | Gal | Make | | | | |
| 5/8 | 298 | | 200 | | | | | | |
| | | | | | | | | | |
| | | | | | | | | | |

Note: What method was used to protect sands if outer strings were pulled?

NOTE: Were bottom hole plugs used? If so, state kind, depth set, and results obtained.

TOOLS USED

Rotary Tools were used from _____ feet to _____ feet. Cable tools were used from _____ feet and from _____ feet to _____ feet and from _____ feet to _____ feet.

Type Rig _____

INITIAL PRODUCTION TEST

Describe initial test whether by flow through tubing or casing or by pumping _____

Amount of Oil Production _____ bbls. Size of choke, if any _____ Length of test _____

Production _____ bbls. Gravity of oil _____ Type of Pump if pump is used, describe _____

| Formation | Top | Bottom | Formation | Top | Bottom |
|------------------|------|--------|--------------------|------|--------|
| Surface | 0 | 140 | TOPS: | | |
| Red Rock & shale | 140 | 375 | Electric log tops: | | |
| Shale & shells | 375 | 1800 | Elevation RB | 1258 | 2158 |
| Lime & shale | 1800 | 2120 | Heebner | | 3317 |
| Shale | 2120 | 2475 | Douglas | | 3480 |
| Shale & lime | 2475 | 2562 | Stalmer | | 3694 |
| Lime & shale | 2562 | 2884 | Layton | | 4026 |
| Shale & lime | 2884 | 3050 | Chat. | | 5249 |
| Lime & shale | 3050 | 3198 | Mississippi | | 4750 |
| Shale & sand | 3198 | 3323 | Kinderhook | | 5114 |
| Shale & lime | 3323 | 3470 | Misener Sd | | 5312 |
| Shale | 3470 | 3600 | Maquoketa | | 5315 |
| Shale & shells | 3600 | 3700 | Viola | | 5333 |
| Shale & sand | 3700 | 3837 | Simpson | | 5343 |
| Lime & shale | 3837 | 3910 | Simpson Sand | | 5366 |
| Shale & sand | 3910 | 3990 | Arbuckle | | 5602 |
| Shale & lime | 3990 | 4044 | T.D. | | 5652 |
| Shale & sand | 4044 | 4145 | | | |
| Lime & shale | 4145 | 4155 | | | |
| Lime | 4155 | 4334 | | | |
| Shale & lime | 4334 | 4415 | | | |
| Lime | 4415 | 4476 | | | |
| Shale & lime | 4476 | 4555 | | | |
| Lime & shale | 4555 | 4612 | | | |
| Shale & sand | 4612 | 4652 | | | |
| Shale & lime | 4652 | 4760 | | | |
| Lime | 4760 | 5135 | | | |
| Shale | 5135 | 5167 | | | |
| Lime | 5167 | 5395 | | | |
| Sand | 5395 | 5452 | | | |
| Sand | 5452 | 5497 | | | |
| Sand & shale | 5497 | 5572 | | | |
| Sand | 5572 | 5617 | | | |
| Lime | 5617 | 5652 | | | |
| T.D. | | 5652 | | | |

I, the undersigned, being first duly sworn, upon oath state that this well record is true, correct, and complete according to the records of this office and to the best of my knowledge and belief.

John D. ... Vice-Pres.
Name and title of representative of company

Subscribed and sworn to before me this _____ day of May, 1956
My Commission expires 10-11-58
Lucille ...
Notary Public

MUDGING
 CELL 158
 5/11/56