


STATE OF KANSAS
STATE CORPORATION COMMISSION

WELL PLUGGING RECORD

Give All Information Completely
Make Required Affidavit
Mail or Deliver Report to:
Conservation Division
State Corporation Commission
800 Biting Building
Wichita, Kansas

NORTH

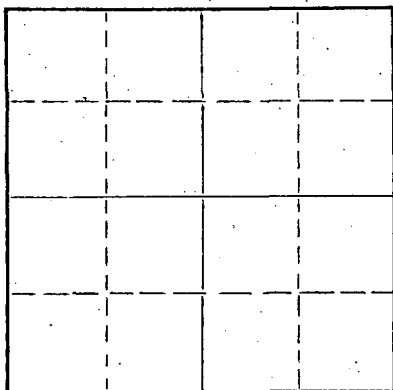

Locate well correctly on above
Section Plat

Barber County. Sec. 36 Twp. 30 Rge. 12 (E) (W)
Location as "NE/CNW%SW%" or footage from lines NE NEMW
Lease Owner Trans Era Petroleum, Inc.
Lease Name Thom Well No. 2
Office Address Russell, Kansas
Character of Well (completed as Oil, Gas or Dry Hole) Dry Hole
Date well completed 4/17/55 19
Application for plugging filed 4/16/55 19
Application for plugging approved 4/16/55 19
Plugging commenced 4/17/55 19
Plugging completed 4/17/55 19
Reason for abandonment of well or producing formation Dry Hole

If a producing well is abandoned, date of last production _____ 19
Was permission obtained from the Conservation Division or its agents before plugging was commenced? Yes

Name of Conservation Agent who supervised plugging of this well M. A. Rives
Producing formation _____ Depth to top _____ Bottom _____ Total Depth of Well 4765 Feet
Show depth and thickness of all water, oil and gas formations.

OIL, GAS OR WATER RECORDS

CASING RECORD

FORMATION	CONTENT	FROM	TO	SIZE	PUT IN	PULLED OUT
				8 5/8	347	none

Describe in detail the manner in which the well was plugged, indicating where the mud fluid was placed and the method or methods used in introducing it into the hole. If cement or other plugs were used, state the character of same and depth placed, from _____ feet to _____ feet for each plug set.

PLUGGING RECORD

Filled hole with heavy mud to 300'. Plug. Used 20 sacks cement through drill pipe.
Filled with heavy mud to 35'. Plug. Used 10 sacks cement.

(If additional description is necessary, use BACK of this sheet)
Name of Plugging Contractor Trans Era Petroleum, Inc.
Address Russell, Kansas

STATE OF KANSAS, COUNTY OF RUSSELL, ss.
H. R. Michaelis (employee of owner) or ~~(owner)~~ of the above-described well, being first duly sworn on oath, says: That I have knowledge of the facts, statements, and matters herein contained and the log of the above-described well as filed and that the same are true and correct. So help me God.

(Signature) H. R. Michaelis
(Address) _____

SUBSCRIBED AND SWORN to before me this 5th day of May, 1955

My commission expires 1-30-57

Margie Cooper
Notary Public.

RECEIVED
STATE CORPORATION COMMISSION
MAY 10 1955
CONSERVATION DIVISION
Wichita, Kansas

PLUGGING
WELL SEC 36 T 30 R 12 W
BOOK PAGE 113 LINE 16

Trans Era Petroleum, Inc.
Thom #2

NE NE NW 36-30-12
Barber County, Kansas

Total Depth: 4765'

Comm: 3/21/55
Comp: 4/17/55

Casing:

8 5/8" @ 347

Cement:

225 sacks of Lehigh

FORMATION	DEPTH
Surface clay & Red Bed & shells	130
Red Bed	135
Sand	210
Shale & shells	347
Red Bed	580
Sand	610
Shale & shells	1200
Sandy Lime & shale	1350
Salt	1460
Shale & Shells	1625
Anhydrite	1655
Shale & shells	1745
Shale & shells	1770
Lime & shale	1860
Lime	1970
Lime & shale	2550
Shale & shells	2715
Shale & lime	2855
Lime & shale	2925
Lime	3005
Lime & shale	3565
Sandy Lime & shale	3600
Sand & shale	3687
Broken Lime streaks of chert	3705
Sand & shale	3781
Lime & shale	3825
Lime	4204
Shale & lime	4235
Lime	4269
Chert & Lime	4336
Lime	4372
Lime & shale	4540
Lime	4637
Lime & sand	4650
Sand	4671
Lime & shale	4735
Lime	4765

STATE OF KANSAS)
) ss:
RUSSELL COUNTY)

I hereby certify that the above information is true and correct to the best of my knowledge.

A. D. Michael

Subscribed and sworn to before me this 5th day of May, 1955.

Margie Cooper
Notary Public

My commission expires: 1-30-57

PLUGGING
WELL SEC 36 T 30 R 12 W
COOK PAGE 13 LINE 16

RECEIVED
STATE CORPORATION COMMISSION
MAY 10 1955
CONSERVATION DIVISION
Wichita, Kansas