


WELL PLUGGING RECORD

Give All Information Completely
Make Required Affidavit
Mail or Deliver Report to:
Conservation Division
State Corporation Commission
800 Biting Building
Wichita, Kansas

Barber County, Sec. 36 Twp. 30 Rge. 12 (E) W (W)

NORTH

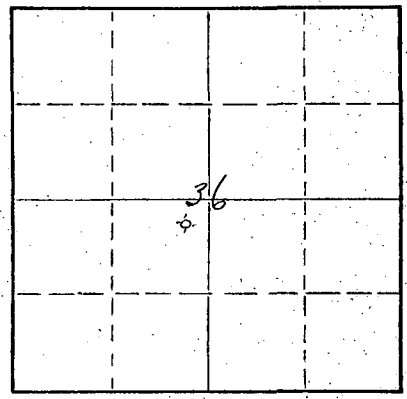

Locate well correctly on above Section Plat

Location as "NE/CNW/SW" or footage from lines NE NE SW
Lease Owner W. J. Coppinger et al
Lease Name Herndon Well No. 1
Office Address 320 Union Natl Bldg., Wichita, Kansas
Character of Well (completed as Oil, Gas or Dry Hole) completed as oil well
Date well completed November 6, 1952 19
Application for plugging filed November 29, 1955 19
Application for plugging approved November 30, 1955 19
Plugging commenced January 7, 1956 19
Plugging completed January 10, 1956 19
Reason for abandonment of well or producing formation no longer commercial producer
If a producing well is abandoned, date of last production September 8 1955
Was permission obtained from the Conservation Division or its agents before plugging was commenced? yes

Name of Conservation Agent who supervised plugging of this well M. A. Rives, Pratt, Ks.
Producing formation Mississippi Depth to top 4296 Bottom 4398 Total Depth of Well 4800 Feet
Show depth and thickness of all water, oil and gas formations. PB TD 4310

OIL, GAS OR WATER RECORDS

CASING RECORD

| FORMATION | CONTENT | FROM | TO | SIZE | PUT IN | PULLED OUT |
|-----------|---------|------|----|--------|--------|------------|
| | | | | 8-5/8" | 407' | none |
| | | | | 5-1/2" | 4296' | 3816' |
| | | | | | | |
| | | | | | | |
| | | | | | | |
| | | | | | | |
| | | | | | | |
| | | | | | | |
| | | | | | | |

Describe in detail the manner in which the well was plugged, indicating where the mud fluid was placed and the method or methods used in introducing it into the hole. If cement or other plugs were used, state the character of same and depth placed, from _____ feet to _____ feet for each plug set.

Filled hole with sand to 4285' - dumped in five sax cement
Plugged off bottom;
Shot off pipe 4043'; failed; tried at 3996', 3945', 3896', 3840' and finally at 3816'
Pulled pipe
Mudded hole to 350' of top, set 10' rock bridge
20 sax cement; mudded hole to 35' of top; set rock bridge and filled to top with 10 sax cement.

(If additional description is necessary, use BACK of this sheet)

Name of Plugging Contractor R & D CASING CO.
Address Ellinwood, Kansas



STATE OF Sedgwick Kansas, COUNTY OF Sedgwick, ss.

W. J. Coppinger (employee of/owner) or (owner or operator) of the above-described well, being first duly sworn on oath, says: That I have knowledge of the facts, statements, and matters herein contained and the log of the above-described well as filed and that the same are true and correct. So help me God.

(Signature) W. J. Coppinger
Wichita, Kansas
(Address)

SUBSCRIBED AND SWORN TO before me this 16th day of January, 19 56

My commission expires March 7, 1956
Mayree Broadus
(Mayree Broadus) Notary Public.

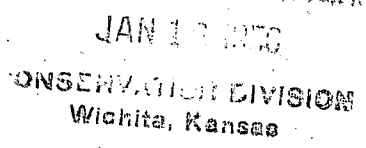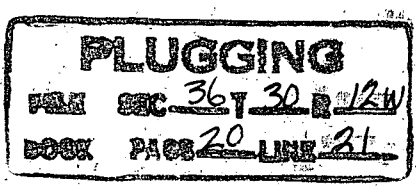

D R I L L E R S L O G

W. J. Coppinger et al

RE: Herndon #1
NE NE SW 36-30s-12w
Barber County, Kansas

Casing Record:

8 5/8" at 407' with 225 sacks cement
5 1/2" at 4296' with 50 sacks posmix cement.

| | |
|-------------------------|------|
| Sand | 40 |
| Sandy Red Bed | 240 |
| Red Bed | 580 |
| Red Bed & Shells | 850 |
| Anhydrite | 880 |
| Red Bed, Shale & Shells | 1375 |
| Shale & Shells | 1530 |
| Lime & Shale | 1825 |
| Lime | 1885 |
| Lime & Shale | 1955 |
| Broken Lime & Shale | 2020 |
| Lime & Shale | 2525 |
| Shale & Shells | 2640 |
| Lime & Shale | 2780 |
| Shale | 2875 |
| Shale & Shells | 2955 |
| Lime & Shale | 3009 |
| Sandy Lime | 3115 |
| Lime | 3220 |
| Lime & Shale | 3460 |
| Sand | 3550 |
| Lime & Shale | 3633 |
| Shale & Sand | 3642 |
| Lime & Shale | 3709 |
| Sand | 3725 |
| Sand & Shale | 3770 |
| Lime & Shale | 3810 |
| Lime | 3828 |
| Lime & Shale | 3880 |
| Lime | 4100 |
| Lime & Shale | 4203 |
| Lime | 4307 |
| Chert | 4325 |
| Lime | 4348 |
| Chert & Lime | 4372 |
| Shale | 4402 |
| Shale & Lime | 4498 |
| Shale | 4550 |
| Shale & Lime | 4582 |
| Shale & Cherty Lime | 4607 |
| Cherty Lime | 4625 |
| Lime | 4650 |
| Lime & Shale | 4683 |
| Shale & Sand | 4707 |
| Simpson shale | 4735 |
| Shale & Lime | 4800 |

Tops:

| | |
|-----------------|-------|
| T Topeka | 3151' |
| T Heebner | 3579' |
| T Iatan | 3770' |
| T Lansing | 3784' |
| T Mississippian | 4296' |
| T Kinderhook | 4398' |
| T Viola | 4574' |
| T Simpson dol. | 4662' |
| T Simpson shale | 4682' |
| T Arbuckle | 4760' |

Rotary Total Depth 4800'
Comm: 10-17-52
Comp: 11-7-52
Elevation: 1685' D.F.

Rotary Total Depth 4800

STATE OF KANSAS:

COUNTY OF SEDGWICK:

I, the undersigned, being duly sworn, on oath state that the above statement and log is a true and correct record and log of the well drilled at the location above described.

S/A. J. Carter

Subscribed and sworn to before me this 13th day of November, 1952.

S/Henry D. Ficken

Notary Public

My commission expires April 18, 1955

(SEAL)

