


WELL PLUGGING RECORD

Give All Information Completely  
Make Required Affidavit  
Mail or Deliver Report to:  
Conservation Division  
State Corporation Commission  
800 Bitting Building  
Wichita, Kansas

Barber County. Sec. 13 Twp. 30S Rge. (E) 11(W)  
Location as "NE/CNW/SW" or footage from lines NE NE NE  
Lease Owner The Bay Petroleum Corporation  
Lease Name Dolbow Well No. 1  
Office Address Box 513 Chase Kansas  
Character of Well (completed as Oil, Gas or Dry Hole) Dry Hole  
Date well completed October 22 19 54  
Application for plugging filed November 1 19 54  
Application for plugging approved October 25 19 54  
Plugging commenced October 22 19 54  
Plugging completed October 22 19 54  
Reason for abandonment of well or producing formation Dry Hole

NORTH

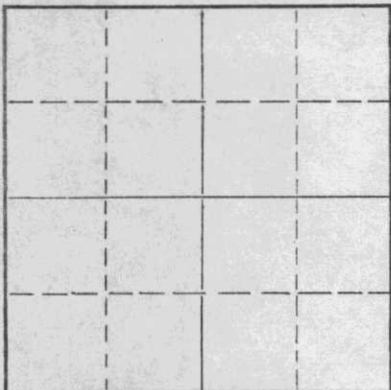

Locate well correctly on above  
Section Plat

If a producing well is abandoned, date of last production \_\_\_\_\_ 19\_\_\_\_  
Was permission obtained from the Conservation Division or its agents before plugging was com-  
menced? Yes

Name of Conservation Agent who supervised plugging of this well M.A. Rives  
Producing formation \_\_\_\_\_ Depth to top \_\_\_\_\_ Bottom \_\_\_\_\_ Total Depth of Well 3912 Feet  
Show depth and thickness of all water, oil and gas formations.

OIL, GAS OR WATER RECORDS

CASING RECORD

FORMATION	CONTENT	FROM	TO	SIZE	PUT IN	PULLED OUT
				8 5/8"	217'	none

Describe in detail the manner in which the well was plugged, indicating where the mud fluid was placed and the method or methods used in introducing it into the hole. If cement or other plugs were used, state the character of same and depth placed, from \_\_\_\_\_ feet to \_\_\_\_\_ feet for each plug set.

Mudded from TD. 3912' to 210',  
Set bridge at 210',  
Mixed 20 sacks cement and spotted through drill pipe,  
Mudded to 35',  
Set bridge at 35',  
Cemented with 10 sacks cement on top of bridge at 35'  
Plugging completed

(If additional description is necessary, use BACK of this sheet)

Name of Plugging Contractor Pickrell Drilling Company  
Address Wichita Kansas

STATE OF Kansas, COUNTY OF Rice, ss.  
Glen E. Armour (employee of owner) or (owner or operator) of the above-described well, being first duly sworn on oath, says: That I have knowledge of the facts, statements, and matters herein contained and the log of the above-described well as filed and that the same are true and correct. So help me God.

(Signature) Glen E. Armour

(Address) \_\_\_\_\_

SUBSCRIBED AND SWORN TO before me this 1 day of November, 1954

Vincent C. Bray  
Notary Public.

My commission expires May 20 1958

**PLUGGING**  
FILE SEC 13 T 30 R 11 W  
BOOK PAGE 22 LINE 32

STATE CORPORATION

NOV - 2 1954

CONSERVATION

Wichita, Kan.

ROTARY DRILLING LOG

COMPANY: C. U. Bay

Rotary Drilling Commenced 10/1/54

LOCATION: Bolow #1  
NE NE NE, Sec. 13-30E-11W  
Barber County, Kansas

Rotary Drilling Completed 10/22/54

CONTRACTOR: PICKRELL DRILLING COMPANY  
Wichita, Kansas

CASING RECORD: 7 Jts (217') of 8 5/8" 2 1/2" Smls.

No oil string was run, hole filled with heavy drilling mud to bridge set at 210', cemented with 20 sack and second bridge set at 35' with 10 sack filling to bottom of cellar.

LOG

(Figures indicate bottom of formation - measurements from top of rotary bushing.)

Sand and gravel	170	Circ. for samples at	3456
Red Rock	217		3510
Red Bed & shale	740		3654
Shale	1095		3715
Shale & shells	1850		3726
Lime	2160		3758
Shale Lime	2205		3800
Lime	2235		3957
Shale & lime	2320		4423
Shale	2380		4427
Lime	2608		4432
Lime & shale	2745		4447
Lime	2890		4692
Lime & shale	3000		4769
Lime	3603		4850
Lime & shale	3659		4857
Lime	3800		4869
Lime & shale	3890		4912
Lime	4427		
Mississippi	4489		
Shale	4678	Slope test at 2240 - 0° off	
Viola Lime	4692	Slope test at 3922 - 0° off	
Lime	4805		
Lime & shale	4819		
Lime	4912		

RTD S.L.M. at 2240 - O.K.  
S.L.M. at 3922 - O.K.

RECEIVED  
STATE CORPORATION COMMISSION  
NOV - 6 1954  
CONSERVATION DIVISION  
Wichita, Kansas

The undersigned, C.W. Sebitt, Attorney-in-Fact for PICKRELL DRILLING COMPANY, hereby certifies in behalf of said Company, that the above is a true and correct log of the formation encountered in drilling the above well as reflected by the Daily Drilling Reports.

PLUGGING  
FILE SEC 13 T 30 R 11W  
BOOK PAGE 22 LINE 32

PICKRELL DRILLING COMPANY  
By C.W. Sebitt  
Attorney-in-Fact

STATE OF KANSAS,  
COUNTY OF SEDGWICK

On this 2nd day of November, 1954, before me the undersigned, a Notary Public, in and for

the County and State aforesaid, personally appeared C. W. Sebitt, to me known to be the identical person who subscribed the name of PICKRELL DRILLING COMPANY to the foregoing instrument as its Attorney-in-Fact and acknowledged to me that he executed the same as his free and voluntary act and deed, and as the free and voluntary act and deed of such company, for the uses and purposes therein set forth.

Given under my hand and seal of office the day and year last above written.

My commission expires: July 30, 1958

Harvey L. Hates  
Notary Public