

WELL PLUGGING RECORD

15-009-15982-0000

Give All Information Completely
Make Required Affidavit
Mail or Deliver Report to:
Conservation Division
State Corporation Commission
211 No. Broadway
Wichita, Kansas

Barton County, Sec. 34 Twp. 16 Rge. 13 (E) (W)

Location as "NE/CNW/SW" or footage from lines NW SW NE

Lease Owner Prairie Oil Field Service

Lease Name Zugg Well No. 2

Office Address Great Bend, Kansas P. O. Box 797

Character of Well (completed as Oil, Gas or Dry Hole) _____

Date well completed _____ 19____

Application for plugging filed 11-23-64 19____

Application for plugging approved 11-24-64 19____

Plugging commenced 11-28-64 19____


Plugging completed 12-12-64 19____

Reason for abandonment of well or producing formation _____

Dry

If a producing well is abandoned, date of last production _____ 19____

Was permission obtained from the Conservation Division or its agents before plugging was commenced? Yes

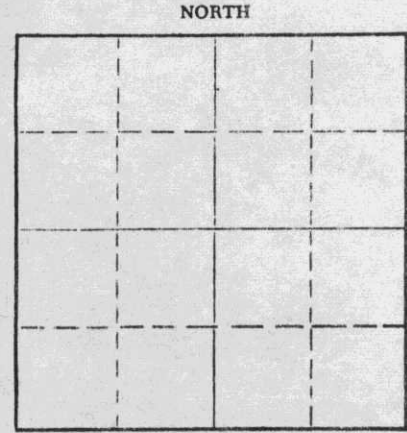

Locate well correctly on above Section Plat

Name of Conservation Agent who supervised plugging of this well Donald Truan

Producing formation _____ Depth to top _____ Bottom _____ Total Depth of Well 3406 Feet

Show depth and thickness of all water, oil and gas formations.

OIL, GAS OR WATER RECORDS

CASING RECORD

FORMATION	CONTENT	FROM	TO	SIZE	PUR IN	PULLED OUT
				8 5/8	266	None
				5 1/2	None	1709

Describe in detail the manner in which the well was plugged, indicating where the mud fluid was placed and the method or methods used in introducing it into the hole. If cement or other plugs were used, state the character of same and depth placed, from _____ feet to _____ feet for each plug set.

Cleaned out cellar. Sanded to 3010'. Dumped 5 sacks of cement. Working pipe.

Working pipe. Shot pipe at 2800' & 2730'. Circulating. Spotted 50 bbl. of oil.

Working pipe.

Working pipe.

Working pipe. Shot pipe at 2100' - 2000' - 1900' - 1800' & 1760'. Pulling pipe.

Pulling pipe. Plugging and bailing. Build rock bridge at 250'. Dumped 25 sacks of cement. Filled hole and rock bridge. Capped well with 10 sacks of cement.

RECEIVED
STATE CORPORATION COMMISSION

12-17-64
DEC 17 1964

(If additional description is necessary, use BACK of this sheet)

Name of Plugging Contractor Forbes Casing Pulling, Inc.

Address P. O. Box 221 Great Bend, Kansas

CONSERVATION DIVISION
Wichita, Kansas

STATE OF Kansas, COUNTY OF Barton, ss.

J. O. Forbes

(employee of owner) or (owner or operator) of the above-described

well, being first duly sworn on oath, says: That I have knowledge of the facts, statements, and matters herein contained and the log of the above-described well as filed and that the same are true and correct. So help me God.

(Signature)

J. O. Forbes
P. O. Box 221 Great Bend, Kansas
(Address)

SUBSCRIBED AND SWORN to before me this 16 day of December, 1964

Alvin Clark

Notary Public.

My commission expires May 27, 1965

COMPANY: Black-Marshall et al
CONTRACTOR: Ferrell-Young Drilling Co.

FARM: Zugg #2
NW SW NE 34-16S-13W
Barton County, Kansas

COMMENCED: 5-13-46
COMPLETED: 5-24-46

CASING RECORD:
8-5/8" 276 100 sacks
5-1/2" 3406 100 "

ELEVATION: 1944

Formation	Depth		
Cellar	4		
Clay, Shells & Hard Post Rock	140		
Rock and shale	195		
Sand and shale	220		
Rock and Shale	276		
Shale and Sand	370		
Shale and Shells	560	TOPS	
Red Bed	660		
Shale and Shells	855		
Anhydrite	875	Anhydrite	855
Shale and Shells	1275	Arbuckle	3405
Salt and Shale	1425		
Salt and Shells	1500		
Shale and Shells	1680		
Line and Shales	1795		
Broken Line	1915		
Line and Shale	2000		
Line	2095		
Shale and Line	2865		
Line	2985		
Line Shale	3005		
Broken Line	3070		
Line and Shale	3145		
Line Shale	3205		
Line	3280		
Line Shale	3360		
Line	3405		
Arbuckle	3407		

RECEIVED
STATE CORPORATION COMMISSION

JAN 25 1965

CONSERVATION DIVISION
Wichita, Kansas

STATE OF KANSAS
BARTON COUNTY SS

We hereby certify this to be a correct and accurate log of the above described well as shown by the daily drilling reports.

FERRELL-YOUNG DRILLING COMPANY

BY James F. Young
Business Manager

Subscribed and sworn to before me this 29th day of May, 1946.

Carmen Reinhardt Leiker
Notary Public

My Commission Expires February 19, 1949.


WELL LOG BUREAU KANSAS GEOLOGICAL SOCIETY
412 Union National Bk. Bldg., Wichita, Kansas

Company BLACK-MARSHALL ET AL
Farm Zugg No. 2.

SEC. 34 T. 16 R. 13 W
NW SW NE

Total Depth. 3407
Comm. 5-13-46 Comp. 5-24-46
Shot or Treated.
Contractor. Ferrell-Young Drlg. Co.
Issued. 7-13-46

County. Barton
KANSAS

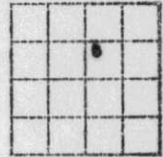

CASING:
8 5/8" 276' Cem.
5 1/2" 3406' Cem.

Elevation. _____

Production. Pot. 596 B

Figures Indicate Bottom of Formations.

cellar	4
clay, shells. & post	
rock hrd	140
rock & shale	195
sand & shale	220
rock & shale	276
shale & sand	370
shale & shells	560
red bed	660
shale & shells	855
anhydrite	875
shale & shells	1275
salt & shale	1425
salt & shells	1500
shale & shells	1680
lime & shales	1795
lime brkn	1915
lime & shale	2000
lime	2095
shale & lime	2865
lime	2985
lime shale	3005
lime brkn	3070
lime & shale	3145
lime shale	3205
lime	3280
lime shale	3360
lime	3405
Arbuckle	3407
Total Depth	

Tops:
Anhydrite 855
Arbuckle 3405

RECEIVED
STATE CORPORATION COMMISSION
MAR 16 1954
CONSERVATION DIVISION
Wichita, Kansas

PLUGGING
FILE SEC 34 T 16 R 13 W
BOOK PAGE 19 LINE 41