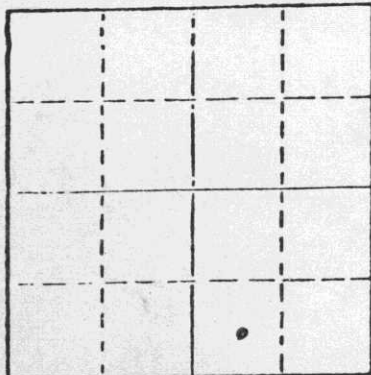


STATE OF KANSAS
STATE CORPORATION COMMISSION

WELL PLUGGING RECORD

Give All Information Completely
Make Required Affidavit
Mail or Deliver Report to
Conservation Division
State Corporation Comm.
245 North Water
Wichita, KS 67202

Locate well correctly on above
Section Plot

Name of Conservation Agent who supervised plugging of this well Mr. Metz
Producing formation _____ Depth to top _____ Bottom _____ Total Depth of Well _____
Show depth and thickness of all water, oil and gas formations.

OIL, GAS OR WATER RECORDS

CASING RECORD

FORMATION	CONTENT	FROM	TO	SIZE	PUT IN	PULLED OUT
Surface Pipe		-0-	232	8 5/8"	232	NONE

Describe in detail the manner in which the well was plugged, indicating where the mud fluid was placed and the method or methods used in introducing it into the hold. If cement or other plugs were used, state the character of same and depth placed, from _____ feet to _____ feet for each plug set.

Filled hole with heavy mud.

#1 plug set @ 240' with 35 sks. cement

#2 plug set @ 40' with 12 sks. cement

#3 plug set in rat hole with 2 sks. cement

RECEIVED
STATE CORPORATION COMMISSION

JUN 23 1977

CONSERVATION DIVISION
Wichita, Kansas

(If additional description is necessary, use BACK of this sheet)

Name of Plugging Contractor Sweetman Drilling, Inc.

STATE OF Kansas COUNTY OF Barton, ss.
Gary L. Hawk (employee of owner) or ~~Conservation Division~~
of the above-described well, being first duly sworn on oath, says: That I have knowledge of the facts, statements, and matters herein contained and the log of the above-described well as filed and that the same are true and correct. So help me God.

(Signature)

Gary L. Hawk
P O Box 645 Great Bend, Kansas 67530
(Address)

SUBSCRIBED AND SWORN TO before me this 21st day of June, 1977

Mary Ann Schwamborn
Notary Public.

My commission expires 7-10-77

WELL LOG
Burke #1
C SW SE 8-35S-7W
Harper, County, Kansas

Name of Operator: Petroleum Resources Co.
P O Box 631
Cushing, Oklahoma 74023

Date Completed: June 14, 1977

FROM	TO	
0	1259	Red bed and shale
1259	4775	Lime and shale
4775	5175	Lime
5175	5355	Lime and shale
5355	5413	Lime
5413		Total Depth

RECEIVED
STATE CORPORATION COMMISSION
JUN 23 1977
CONSERVATION DIVISION
Wichita, Kansas

STATE OF KANSAS

COUNTY OF BARTON ss

Gary L. Hawk, Secretary of Sweetman Drilling, Inc., being first duly sworn on oath says: That I have knowledge of the facts, statements and matters herein contained and the log of the above described well as filed and that the same are true and correct.

Gary L. Hawk
Gary L. Hawk

Subscribed and sworn before me this 21st day of June, 1977.

Mary Ann Schwamborn
Notary Public Barton County

My Commission Expires 7-10-77.

