

CARD MUST BE TYPED

State of Kansas
NOTICE OF INTENTION TO DRILL
(see rules on reverse side)

CARD MUST BE SIGNED

Starting Date: July 7 1984
month day year

API Number 15- 007-01,006-00-01

OPERATOR: License # 5171
Name TXO Production Corp.
Address 200 W. Douglas, Suite 300
City/State/Zip Wichita, KS 67202
Contact Person Jerry Collins
Phone 316-265-9441

SW NE NW Sec 20 Twp 34 S, Rge. 13 East West
(location)
4290 Ft North from Southeast Corner of Section
3630 Ft West from Southeast Corner of Section
(Note: Locate well on Section Plat on reverse side)

CONTRACTOR: License # 6165
Name FWA Drilling Co., Inc.
City/State Yukon, OK 73099

Nearest lease or unit boundary line 990 feet.
County Barber
Lease Name MEYER 'B' Well # 1
Domestic well within 330 feet: yes no
Municipal well within one mile: yes no

Well Drilled For: Well Class: Type Equipment:
 Oil Swd Infield Mud Rotary
 Gas Inj Pool Ext. Air Rotary
 OWWO Expl Wildcat Cable

Depth to Bottom of fresh water 100 feet
Lowest usable water formation Harper Siltstone
Depth to Bottom of usable water 200 feet
Surface pipe by Alternate: 1 2
Surface pipe to ~~set~~ 431 feet
Conductor pipe if any required 0 feet
Ground surface elevation TBD feet MSL.
This Authorization Expires 7/2/84 / 12/85

If OWWO: old well info as follows:

Operator Skelly Oil Company
Well Name M. B. Hull #1
Comp Date 6-26-64 Old Total Depth 4171'
Projected Total Depth 4950 feet
Projected Formation at TD Miss
Expected Producing Formations Miss

Approved By [Signature]

I certify that we will comply with K.S.A. 55-101, et seq., plus eventually plugging hole to K.C.C. specifications.

Date 7-2-84 Signature of Operator or Agent


Jerry W. Collins Title Drlg & Completion Engineer
Form C-1 4/84

MHC/NOHE 7-2-84

Must be filed with the K.C.C. five (5) days prior to commencing well
This card void if drilling not started within six (6) months of date received by K.C.C.

Important procedures to follow :

**A Regular Section of Land
1 Mile = 5,280 Ft.**

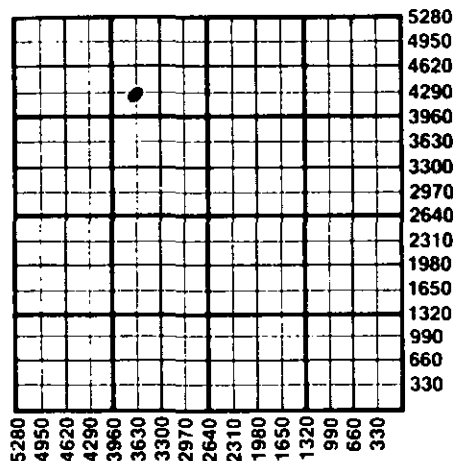

1. Notify District office before setting surface casing.
2. Set surface casing by circulating cement to the top.
3. File completion forms ACO-1 with K.C.C. within 90 days of well completion, following instructions on ACO-1, side 1, and including copies of wireline logs.
4. Notify District office 48 hours prior to old well workover or re-entry.
5. Prior to plugging, prepare a plugging plan, then obtain agreement from the appropriate district office for an approved plugging plan.
6. Submit plugging report (CP-4) to K.C.C. after plugging is completed.
7. Obtain an approved injection docket number before disposing of salt water.
8. Notify K.C.C. within 10 days when injection commences or terminates.
9. If an alternate 2 completion, cement in the production pipe from below any usable water to surface within 120 days of spud date.

State Corporation Commission of Kansas
Conservation Division
200 Colorado Derby Building
Wichita, Kansas 67202
(316) 263-3238