

*COR

EFFECTIVE DATE: 5-17-92

State of Kansas

NOTICE OF INTENTION TO DRILL

Must be approved by the K.C.C. five (5) days prior to commencing well

Expected Spud Date: May 12, 1992
Spot: 160' S of C S/2 SW Sec 2 Twp 30 S, Rg 13W East
85' N of C S2 S2 SW
* 415' 500' feet from South / North line of Section
3960' feet from East / West line of Section

OPERATOR: License # 5056
Name: F. G. HOLL COMPANY
Address: P.O. BOX 780167
City/State/Zip: Wichita, Kansas 67278-0167
Contact Person: Elwyn H. Nagel
Phone: (316) 684-8481

CONTRACTOR: License #: 5142
Name: Sterling Drilling Company

Well Drilled For: Well Class: Type Equipment:
X Oil ... Enh Rec ... Infield ..X Mud Rotary
X Gas ... Storage X Pool Ext. ... Air Rotary
... OUVVO ... Disposal ... Wildcat ... Cable
... Seismic; ... # of Holes ... Other
If OUVVO: old well information as follows:
Operator:
Well Name:
Comp. Date: Old Total Depth

Corrected 6-17-92 C.B.

IS SECTION X REGULAR IRREGULAR?
(NOTE: Locate well on the Section Plat on Reverse Side)
County: Barber
Lease Name: ALEXANDER Well #: 1-2
Field Name: Clara Ext.
Is this a Prorated/Spaced Field? ... yes X no
Target Formation(s): Lan., Simp., Sand, Arbuckle
Nearest lease or unit boundary: 500'
Ground Surface Elevation: 1920' Est. feet MSL
Water well within one-quarter mile: ... yes X no
Public water supply well within one mile: ... yes X no
Depth to bottom of fresh water: 130'
Depth to bottom of usable water: 180'
Surface Pipe by Alternate: X 1 2
Length of Surface Pipe Planned to be set: 200'
Length of Conductor pipe required: NA
Projected Total Depth: 4650'
Formation at Total Depth: Arbuckle
Water Source for Drilling Operations:
X well ... farm pond ... other
DWR Permit #: (Applied for by Sterling Drlg.)
Will Cores Be Taken? ... yes X no
If yes, proposed zone:

Directional, Deviated or Horizontal wellbore? ... yes X no
If yes, true vertical depth:
Bottom Hole Location:

*was 160'S. of C S/2 SW ; 500' fsl AFFIDAVIT * IS 85' N of C S2 S2 SW ; 415 fsl

The undersigned hereby affirms that the drilling, completion and eventual plugging of this well will comply with K.S.A. 55-101, et. seq.
It is agreed that the following minimum requirements will be met:

- 1. Notify the appropriate district office prior to spudding of well;
- 2. A copy of the approved notice of intent to drill shall be posted on each drilling rig;
- 3. The minimum amount of surface pipe as specified below shall be set by circulating cement to the top; in all cases surface pipe shall be set through all unconsolidated materials plus a minimum of 20 feet into the underlying formation;
- 4. If the well is dry hole, an agreement between the operator and the district office on plug length and placement is necessary prior to plugging;
- 5. The appropriate district office will be notified before well is either plugged or production casing is cemented in;
- 6. IF AN ALTERNATE II COMPLETION, PRODUCTION PIPE SHALL BE CEMENTED FROM BELOW ANY USABLE WATER TO SURFACE WITHIN 120 DAYS OF SPUD DATE. IN ALL CASES, NOTIFY DISTRICT OFFICE PRIOR TO ANY CEMENTING.

I hereby certify that the statements made herein are true and to the best of my knowledge and belief.
Date: 5-7-92 Signature of Operator or Agent: [Signature] Title: Exploration Manager

FOR KCC USE:
API # 15-007-22400-0000
Conductor pipe required None feet
Minimum surface pipe required 300 feet per Alt. (X)
Approved by: D.G. 5-12-92 COR. C.B. 6-17-92
This authorization expires: 11-12-92
(This authorization void if drilling not started within 6 months of effective date.)
Spud date: Agent:

REMEMBER TO:

- File Drill Pit Application (form CDP-1) with Intent to Drill;
- File Completion Form ACO-1 within 120 days of spud date;
- File acreage attribution plat according to field proration orders;
- Notify appropriate district office 48 hours prior to workover or re-
- Submit plugging report (CP-4) after plugging is completed;
- Obtain written approval before disposing or injecting salt water.

Mail to: Conservation Division, 200 Colorado Derby Building, 202 W. First St., Wichita, Kansas 67202-1288

RECEIVED
KANSAS CORPORATION COMMISSION

JUN 15 1992
6-15-92
CONSERVATION DIVISION
WICHITA, KS

MAILED

JUL 29 1992

CONSERVATION DIVISION
Wichita, Kansas

CONSERVATION DIVISION
WICHITA, KS

MAY 8 1992

RECEIVED
KANSAS CORPORATION COMMISSION

2
30
14

IN ALL CASES PLOT THE INTENDED WELL ON THE PLAT BELOW

PLAT OF ACREAGE ATTRIBUTABLE TO A WELL IN A PRORATED OR SPACED FIELD

If the intended well is in a prorated or spaced field, please fully complete this side of the form. If the intended well is in a prorated or spaced field complete the plat below showing that the well will be properly located in relationship to other wells producing from the common source of supply. Please show all the wells within 1 mile of the boundaries of the proposed acreage attribution unit for gas wells and within 1/2 mile of the boundaries of the proposed acreage attribution unit for oil wells.



API NO. 15- _____
 OPERATOR F. G. HOLL COMPANY LOCATION OF WELL: COUNTY Barber
 LEASE ALEXANDER * 500' 415' feet from south/north line of section
 WELL NUMBER 1-2 3960' feet from east/west line of section
 FIELD Clara Ext. SECTION 2 TWP 30 -RG 14W

NUMBER OF ACRES ATTRIBUTABLE TO WELL NA IS SECTION X REGULAR or IRREGULAR
 QTR/QTR/QTR OF ACREAGE _____ IF SECTION IS IRREGULAR, LOCATE WELL FROM NEAREST CORNER BOUNDARY.

Section corner used: NE NW SE SW

PLAT

(Show location of the well and shade attributable acreage for prorated or spaced wells.)
 (Show footage to the nearest lease or unit boundary line.)

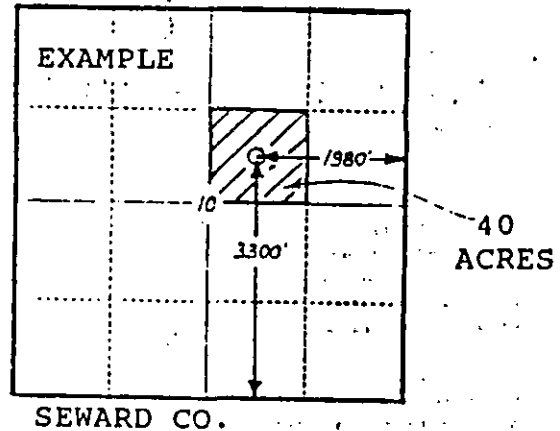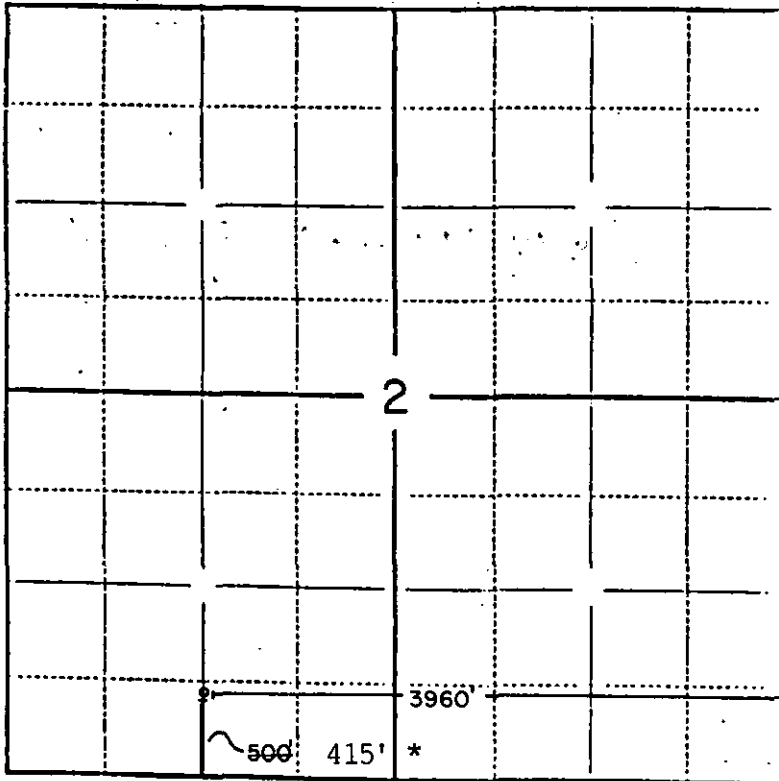

In plotting the proposed location of the well, you must show:

- 1) The manner in which you are using the depicted plat by identifying section lines, i.e. 1 section, 1 section with 8 surrounding sections, 4 sections, etc.;
- 2) the distance of the proposed drilling location from the section's south/north and east/west lines; and
- 3) the distance to the nearest lease or unit boundary line.