

CARD MUST BE TYPED

State of Kansas

CARD MUST BE SIGNED

NOTICE OF INTENTION TO DRILL

(see rules on reverse side)

Starting Date MAY 22, 1987
month day yearAPI Number 15- 007-01,019-00-01OPERATOR: License # 08129— East
NE NE SW Sec. 19 Twp. 30 S. Rg. 11 WestName AMERICAN INTERMOUNTAIN DEVELOPEMENT CORP.Address 515 WATSONCity/State/Zip PRATT, KS. 67124Contact Person DICK ARMERPhone 1-672-315723.40 Ft. from South Line of Section3070 Ft. from East Line of Section

(Note: Locate well on Section Plat on reverse side)

CONTRACTOR: License # 5302Nearest lease or unit boundary line 330 feetCounty BARBERName RED TIGER DRILLING Co.Lease Name WULF "A" Well # 1City/State WICHITA, KSGround surface elevation 1840 feet MSL

Well Drilled For: Well Class: Type Equipment:

Domestic well within 330 feet: —yes no Oil — SWD — Infield Mud RotaryMunicipal well within one mile: —yes no Gas — Inj — Pool Ext. — Air RotarySurface pipe by Alternate: ALREADY SET ~~1~~ ~~2~~ ~~3~~ OWWO Expl Wildcat — CableDepth to bottom of fresh water 120'

If OWWO: old well info as follows:

Depth to bottom of usable water 200' ~~200'~~Operator H. A. HershfieldSurface pipe ~~planned to be set~~ AT 243' (10 3/4")Well Name #1 WulfProjected Total Depth 4500 feetComp Date DEA 1-18-86 Old Total Depth 9966Formation M1551551 P1

I certify that well will comply with K.S.A. 55-101, et seq., plus eventually plugging hole to KCC specifications.

Date MAY 13, 1987 Signature of Operator (or Agent) Charles R. King Title _____

For KCC Use:


Conductor Pipe Required _____ feet; Minimum Surface Pipe Required 200 feet per Alt. 4 2 8This Authorization Expires 11-13-87 Approved By _____ 5-13-87

Must be filed with the K.C.C. five (5) days prior to commencing well
This card void if drilling not started within six (6) months of date received by K.C.C.

Important procedures to follow:

1. Notify District office before setting surface casing.
2. Set surface casing by circulating cement to the top.
3. File completion forms ACO-1 with K.C.C. within 90 days of well completion, following instructions on ACO-1, side 1, and including copies of wireline logs.
4. Notify District office 48 hours prior to old well workover or re-entry.
5. Prior to filing Intent, prepare a proposed plugging plan in case well is D & A, then obtain approval of plan when calling district office prior to setting surface pipe.
6. Submit plugging report (CP-4) to K.C.C. after plugging is completed.
7. Obtain an approved injection docket number before disposing of salt water.
8. Notify K.C.C. within 10 days when injection commences or terminates.

A Regular Section of Land
1 Mile = 5,280 Ft.

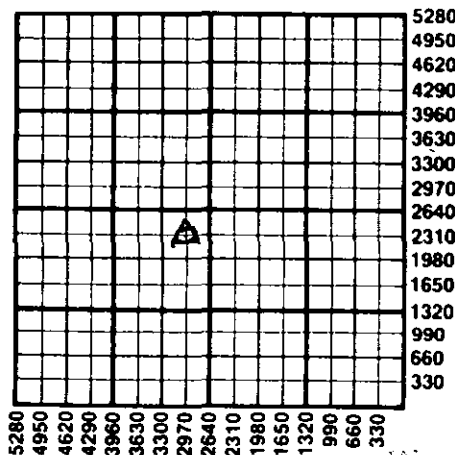

RECEIVED

9. If an alternate 2 completion, cement in the production pipe from below any usable water to surface within 120 days of spud date.

MAY 17 1987

CONSERVATION DIVISION
Wichita, Kansas

State Corporation Commission of Kansas
Conservation Division
200 Colorado Derby Building
Wichita, Kansas 67202
(316) 263-3238