

CARD MUST BE TYPED

State of Kansas

CARD MUST BE SIGNED

NOTICE OF INTENTION TO DRILL

(see rules on reverse side)

Expected Spud Date..... 11 15 87
month day year

API Number 15-077-21, 164-00-00

DA ✓

OPERATOR: License # 6568

SW/4 Sec. 13 Twp. 35 S, Rg. 7 East West

Name Kaiser-Francis Oil Company

Address P. O. Box 21468

City/State/Zip Tulsa, OK 74121-1468

Contact Person Mike Knapp

Phone (918) 494-0000

330 Ft. from South Line of Section

3750 Ft. from East Line of Section

(Note: Locate well on Section Plat on reverse side)

CONTRACTOR: License # "Not yet selected."

Nearest lease or unit boundary line feet

County Harper

Lease Name Lear Well # 1

Name

Ground surface elevation 1291 feet MSL

City/State

Domestic well within 330 feet: ___yes no

Well Drilled For: Well Class: Type Equipment:

Municipal well within one mile: ___yes no

Oil Storage Infield Mud Rotary

Depth to bottom of fresh water 100'

Gas Inj Pool Ext Air Rotary

Depth to bottom of usable water Nippewalla 200'

OWWO Expl Wildcat Cable

Surface pipe by Alternate: 1 2 ___

If OWWO: old well info as follows:

Surface pipe planned to be set 250'

Operator

Conductor pipe required -0-

Well Name

Projected Total Depth 3800' feet

Comp Date Old Total Depth

Formation Tonkawa Sand

I certify that well will comply with K.S.A. 55-101, et seq., plus eventually plugging hole to KCC specifications.

Date Signature of Operator or Agent Title

For KCC Use:

Conductor Pipe Required feet; Minimum Surface Pipe Required 220 feet per Alt.

This Authorization Expires 5-9-88 Approved By [Signature] 11-8-87


EFFECTIVE DATE: 11-14-87

Must be filed with the K.C.C. five (5) days prior to commencing well
 This card void if drilling not started within six (6) months of date received by K.C.C.

Important procedures to follow:

1. Notify District office before setting surface casing.
2. Set surface casing by circulating cement to the top.
3. File completion forms ACO-1 with K.C.C. within 120 days of well spud date, following instructions on ACO-1, side 1, and including copies of wireline logs.
4. Notify District office 48 hours prior to old well workover or re-entry.
 Prior to filing Intent, prepare a proposed plugging plan in case well is D & A, then obtain approval of plan when calling district office prior to setting surface pipe.
5. Submit plugging report (CP-4) to K.C.C. after plugging is completed.
6. Obtain an approved injection docket number before disposing of salt water.
7. Notify K.C.C. within 10 days when injection commences or terminates.
8. If an alternate 2 completion, cement in the production pipe from below any usable water to surface within 120 days of spud date.

**A Regular Section of Land
 1 Mile = 5,280 Ft.**

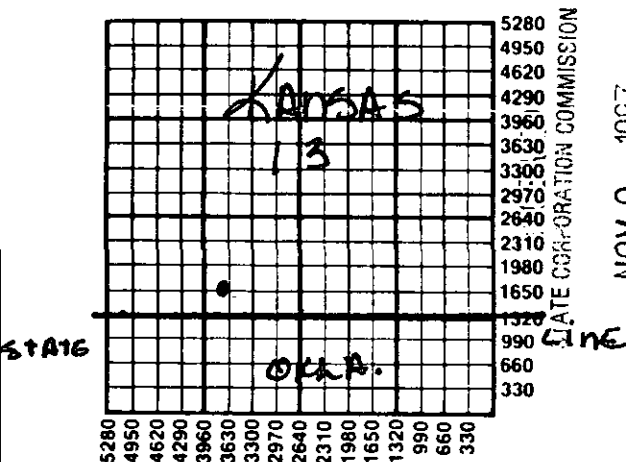

State Corporation Commission of Kansas
 Conservation Division
 200 Colorado Derby Building
 Wichita, Kansas 67202-1212
 (316) 263-3238