

CARD MUST BE TYPED

State of Kansas

CARD MUST BE SIGNED

# NOTICE OF INTENTION TO DRILL

(see rules on reverse side)

Starting Date ..... 5 ~~17~~ 86  
month day year 1:57

API Number 15— 077-26132-00-00

OPERATOR: License # 5171

C NW SE ..... Sec. 10 Twp. 35 S, Rg. 7 ..... XX East West  
1980 ..... Ft. from South Line of Section  
1980 ..... Ft. from East Line of Section

(Note: Locate well on Section Plat on reverse side)

Name ..... TXO PRODUCTION CORP.  
Address ..... 155 N. Market, Suite 1000  
City/State/Zip ..... Wichita, Ks 67202  
Contact Person. G. Wurdeman  
Phone ..... 316-269-7660

Nearest lease or unit boundary line ..... 330 feet  
County ..... Harper  
Lease Name ..... Burchfiel Estate Well # 1

CONTRACTOR: License # 5107  
Name ..... H-30 Drilling, Inc.  
City/State ..... 251 N. Water, Wichita, Ks 67202

Ground surface elevation ..... 1271 feet MSL  
Domestic well within 330 feet: ..... yes X no  
Municipal well within one mile: ..... yes X no

Well Drilled For: Well Class: Type Equipment:  
X Oil SWD Infield X Mud Rotary  
X Gas Inj. Pool Ext. Air Rotary  
OWWO Expl X Wildcat Cable

Depth to bottom of fresh water .....  
Depth to bottom of usable water ..... 225 200  
Surface pipe by Alternate: ..... 1 X 2  
Surface pipe planned to be set ..... 250'  
Conductor pipe required ..... 0  
Projected Total Depth ..... 4150 feet  
Formation ..... Stalnaker

If OWWO: old well info as follows:  
Operator .....  
Well Name .....  
Comp Date ..... Old Total Depth .....

I certify that well will comply with K.S.A. 55-101, et seq., plus eventually plugging hole to KCC specifications.  
Date ..... 5-15-86 ..... Signature of Operator or Agent ..... Jeffery S. Childs ..... Title. Drilling Engineer.....

For KCC Use:  
Conductor Pipe Required ..... feet; Minimum Surface Pipe Required ..... 200 feet per Mt. 1 24  
This Authorization Expires ..... 11-15-86 ..... Approved By ..... 5-15-86 .....


*Handwritten signature and initials*  
11-15-86  
5-15-86  
1 24

Must be filed with the K.C.C. five (5) days prior to commencing well  
This card void if drilling not started within six (6) months of date received by K.C.C.

### Important procedures to follow:

1. Notify District office before setting surface casing.
2. Set surface casing by circulating cement to the top.
3. File completion forms ACO-1 with K.C.C. within 90 days of well completion, following instructions on ACO-1, side 1, and including copies of wireline logs.
4. Notify District office 48 hours prior to old well workover or re-entry.
5. Prior to filing Intent, prepare a proposed plugging plan in case well is D & A, then obtain approval of plan when calling district office prior to setting surface pipe.
6. Submit plugging report (CP-4) to K.C.C. after plugging is completed.
7. Obtain an approved injection docket number before disposing of salt water.
8. Notify K.C.C. within 10 days when injection commences or terminates.
9. If an alternate 2 completion, cement in the production pipe from flow any usable water to surface within 120 days of spud date.

### A Regular Section of Land 1 Mile = 5,280 Ft.

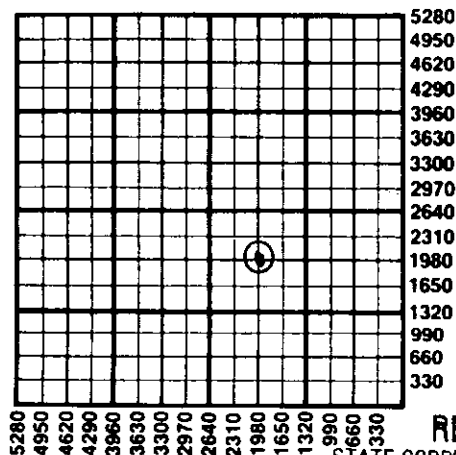

RECEIVED  
STATE CORPORATION COMMISSION

MAY 15 1986

CONSERVATION DIVISION  
Wichita, Kansas

State Corporation Commission of Kansas  
Conservation Division  
200 Colorado Derby Building  
Wichita, Kansas 67202  
(316) 263-3238