

CARD MUST BE TYPED

State of Kansas

CARD MUST BE SIGNED

NOTICE OF INTENTION TO DRILL

(see rules on reverse side)

Starting Date 5/7/86
month day year

API Number 15— 007-22,135-00-00

OPERATOR: License # 4752

N/2 NW NE Sec. 16 Twp 31 S. Rg. 12 East West

Name Source Petroleum

4950 Ft. from South Line of Section

Address 910 Century Plaza Bldg.

1980 Ft. from East Line of Section

City/State/Zip Wichita, Kansas 67202

(Note: Locate well on Section Plat on reverse side)

Contact Person John D. Howard, Jr.

Nearest lease or unit boundary line 330 feet

Phone 316-262-7397

County Barber

CONTRACTOR: License # 5302

Lease Name Elliot "C" Well # 1

Name Red Tiger Drilling Co.

Ground surface elevation 1690 feet MSL

City/State Wichita, Kansas

Domestic well within 330 feet: yes no

Well Drilled For:

Well Class: Type Equipment:

Municipal well within one mile: yes no

Oil SWD Infield Mud Rotary

Depth to bottom of fresh water 80'

Gas Inj Pool Ext. Air Rotary

Depth to bottom of usable water 200'

OWWO Expl Wildcat Cable

Surface pipe by Alternate: 2

If OWWO: old well info as follows:

Surface pipe planned to be set 300'

Operator

Conductor pipe required None

Well Name

Projected Total Depth 4900 feet

Comp Date Old Total Depth

Formation Simpson

I certify that well will comply with K.S.A. 55-101, et seq., plus eventually plugging hole to KCC specifications.

Date 5/6/86 Signature of Operator or Agent John D. Howard, Jr. Title Partner

For KCC Use:

Conductor Pipe Required feet; Minimum Surface Pipe Required 200 feet per Alt. 04

This Authorization Expires 11-7-86 Approved By 5-7-86


RCM/KOMZ

Must be filed with the K.C.C. five (5) days prior to commencing well
This card void if drilling not started within six (6) months of date received by K.C.C.

Important procedures to follow:

1. Notify District office before setting surface casing.
2. Set surface casing by circulating cement to the top.
3. File completion forms ACO-1 with K.C.C. within 90 days of well completion, following instructions on ACO-1, side 1, and including copies of wireline logs.
4. Notify District office 48 hours prior to old well workover or re-entry.
5. Prior to filing Intent, prepare a proposed plugging plan in case well is D & A, then obtain approval of plan when calling district office prior to setting surface pipe.
6. Submit plugging report (CP-4) to K.C.C. after plugging is completed.
7. Obtain an approved injection docket number before disposing of salt water.
8. Notify K.C.C. within 10 days when injection commences or terminates.

A Regular Section of Land 1 Mile = 5,280 Ft.

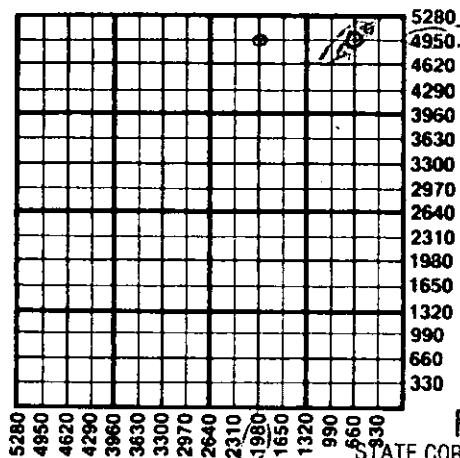

RECEIVED

STATE CORPORATION COMMISSION

MAY 6 - 1986

CONSERVATION DIVISION
Wichita, Kansas

If an alternate 2 completion, cement in the production pipe from below any usable water to surface within 120 days of spud date.

State Corporation Commission of Kansas
Conservation Division
200 Colorado Derby Building
Wichita, Kansas 67202
(316) 263-3238