

CARD MUST BE TYPED

State of Kansas
NOTICE OF INTENTION TO DRILL
(see rules on reverse side)

CARD MUST BE SIGNED

Starting Date: December 8, 1984
month day year

API Number 15- 007-21,972-00-00

OPERATOR: License # 6327
Name KAN-EX, INC.
Address 110 S. Main, Suite 800
City/State/Zip Wichita, Kansas 67202
Contact Person Bruce F. Welner
Phone 316-267-2585

NE NW Sec 24 Twp 30 S. Rge 11W
(location) 4620 Ft North from Southeast Corner of Section
3300 Ft West from Southeast Corner of Section
(Note: Locate well on Section Plat on reverse side)

CONTRACTOR: License # 5149
Name Wheatstate Oilfield Services Inc.
City/State Pratt, Kansas

Nearest lease or unit boundary line 660 feet.
County Barber
Lease Name Douthett Well# 1-24

Well Drilled For: Well Class: Type Equipment:
 Oil Swd Infield Mud Rotary
 Gas Inj Pool Ext. Air Rotary
 OWWO Expl Wildcat Cable

Domestic well within 330 feet: yes no
Municipal well within one mile: yes no

If OWWO: old well info as follows:
Operator
Well Name
Comp Date Old Total Depth
Projected Total Depth 4800' feet
Projected Formation at TD Simpson
Expected Producing Formations Douglas

Depth to Bottom of fresh water 100 feet
Lowest usable water formation Permian
Depth to Bottom of usable water 200 feet
Surface pipe by Alternate: 1 2
Surface pipe to be set 300 feet
Conductor pipe if any required
Ground surface elevation feet MSL.
This Authorization Expires 5-28-85
Approved By 11-28-84 [Signature]

I certify that we will comply with K.S.A. 55-101, et seq., plus eventually plugging hole to K.C.C. specifications.


Date 11-27-1984
Signature of Operator or Agent [Signature]

Bruce F. Welner President
MACINCHIE 11/28/84
Form C-1 4/84

Must be filed with the K.C.C. five (5) days prior to commencing well
This card void if drilling not started within six (6) months of date received by K.C.C.

Important procedures to follow:

**A Regular Section of Land
1 Mile = 5,280 Ft.**

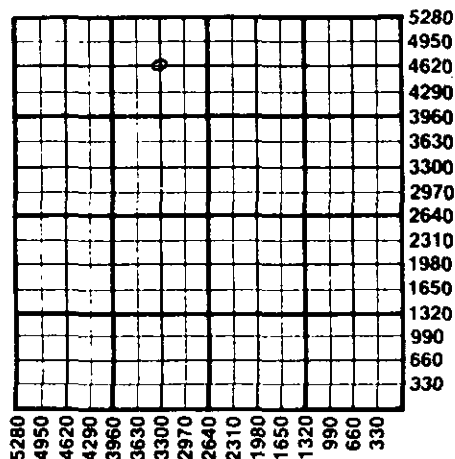

1. Notify District office before setting surface casing.
2. Set surface casing by circulating cement to the top.
3. File completion forms ACO-1 with K.C.C. within 90 days of well completion, following instructions on ACO-1, side 1, and including copies of wireline logs.
4. Notify District office 48 hours prior to old well workover or re-entry.
5. Prior to plugging, prepare a plugging plan, then obtain agreement from the appropriate district office for an approved plugging plan.
6. Submit plugging report (CP-4) to K.C.C. after plugging is completed.
7. Obtain an approved injection docket number before disposing of salt water.
8. Notify K.C.C. within 10 days when injection commences or terminates.
9. If an alternate 2-completion, cement in the production pipe from below any usable water to surface within 120 days of spud date.

STATE

NOV 28 1984
State Corporation Commission of Kansas
Conservation Division
CONSERVATION DIVISION 200 Colorado Derby Building
Wichita, Kansas Wichita, Kansas 67202
(316) 263-3238