

FORM MUST BE TYPED  
FORM C-1 12/88

AMENDED 8/8/89  
State of Kansas

NOTICE OF INTENTION TO DRILL

Must be approved by the K.C.C. five (5) days prior to commencing well

\* Corrected spot location, ground surface elevation and total depth, surface pipe  
FORM MUST BE SIGNED

ALL BLANKS MUST BE FILLED

Expected Spud Date 8 9 1989  
month day year

NW \* SW NE Sec 23 Twp 30 S, Rg 11 East  
West

3630 feet from South line of Section  
2310 feet from East line of Section

(Note: Locate well on Section Plat Below)

OPERATOR: License # 3667  
Name: Source Petroleum  
Address: 200 W. Douglas, Ste. 820  
City/State/Zip: Wichita, Kansas 67202  
Contact Person: John D. Howard, Jr.  
Phone: (316) 262-7397

County: Barber  
Lease Name: Douthett "A" Well #: 1  
Field Name: Wildcat

Is this a Prorated Field? yes X no

Target formation(s): Mississippian

Nearlest lease or unit boundary: 330'

Ground Surface Elevation: \* 1802 feet MSL

Domestic well within 330 feet: yes X no

Municipal well within one mile: yes X no

Depth to bottom of fresh water: 200' 180'

Depth to bottom of usable water: 250' 180'

Surface Pipe by Alternate: X 1 2

Length of Surface Pipe Planned to be set: \* 275'

Length of Conductor pipe required: NONE

Projected Total Depth: \* 4900'

Formation at Total Depth: Arbuckle

Water Source for Drilling Operations:

X well farm pond other

D-R Permit #: \_\_\_\_\_

Will Cores Be Taken? yes X no

If yes, proposed zone: \_\_\_\_\_

CONTRACTOR: License #: 5418  
Name: Allen Drilling Company

Well Drilled For: Well Class: Type Equipment:

X Oil ... Inj ... Infield X Mud Rotary  
... Gas ... Storage ... Pool Ext. ... Air Rotary  
... OAWD ... Disposal X Wildcat ... Cable  
... Seismic; ... # of Holes

If OAWD: old well information as follows:

Operator: \_\_\_\_\_

Well Name: \_\_\_\_\_

Comp. Date: \_\_\_\_\_ Old Total Depth \_\_\_\_\_

Directional, Deviated or Horizontal wellbore? yes X no

If yes, total depth location: \_\_\_\_\_

WAS: NW-SE-N/E; G.L. EST. 1805'  
Surface pipe @ 300'; PTD 4800'

AFFIDAVIT


The undersigned hereby affirms that the drilling, completion and eventual plugging of this well will comply with K.S.A. 55-101, et. seq.

It is agreed that the following minimum requirements will be met:

1. The appropriate district office shall be notified before setting surface pipe;
2. The minimum amount of surface pipe as specified above shall be set by circulating cement to the surface, in all cases surface pipe shall be set through all unconsolidated materials plus a minimum of 20 feet into the underlying formation;
3. If the well is dry, a plugging proposal shall be submitted to the district office. An agreement between the operator and the district office on plug length and placement is necessary prior to plugging;
4. The appropriate district office will be notified before well is either plugged or production casing is cemented in;
5. If an Alternate II completion, production pipe shall be cemented from below any usable water to surface within 120 days of spud date. In all cases, notify district office prior to any cementing.

I hereby certify that the statements made herein are true, and to the best of my knowledge and belief.

Date: 8/3/89 Signature of Operator or Agent: John D. Howard, Jr. Title: General Manager

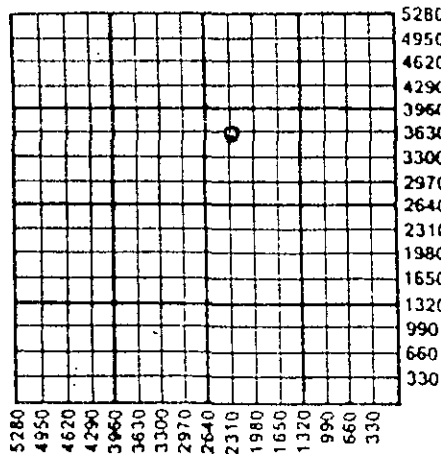

RECEIVED  
STATE CORPORATION COMMISSION

AUG 9 1989

CONSERVATION DIVISION  
Wichita, Kansas

FOR REC USE: **VD**

API # 15- 007-22,255-00-00

Conductor pipe required NONE feet

Minimum surface pipe required 200' feet per Alt. **OX**

Approved by: DPW 8-04-89 ORIG; DPW 8-9-89

EFFECTIVE DATE: 8-09-89

This authorization expires: 2-04-90

This authorization void if drilling not started within 6 months of effective date.)

Spud date: \_\_\_\_\_ Agent: \_\_\_\_\_

23  
30  
11W

REMEMBER TO:

- File Drill Pit Application (form CDP-1) with Intent to Drill;
- File Completion Form ACO-1 within 120 days of spud date;
- File acreage attribution plat according to field proration orders;
- Notify appropriate district office 48 hours prior to workover or re-entry;
- Submit plugging report (CP-4) after plugging is completed;
- Obtain written approval before disposing or injecting salt water.

Mail to: Conservation Division, 200 Colorado Derby Building, 202 W. First St., Wichita, Kansas 67202-1286.