

CARD MUST BE TYPED

State of Kansas
NOTICE OF INTENTION TO DRILL
(see rules on reverse side)

CARD MUST BE SIGNED

Starting Date: November 20, 1984
month day year

API Number is 007-21,951-00-00

OPERATOR: License # 5601
Name Associated Petroleum Consultants, Inc.
Address Suite 600 - One Main Place
City/State/Zip Wichita, KS 67202
Contact Person Steve Wisotsky
Phone (316) 265-9385

East
G. SW SW. . . . Sec. 1. Twp 31. S. Rge. 12. West
(location)

660 Ft North from Southeast Corner of Section
4620 Ft West from Southeast Corner of Section
(Note: Locate well on Section Plat on reverse side)

CONTRACTOR: License # 5867
Name Heartland Drilling, Inc.
City/State Wichita, KS

Nearest lease or unit boundary line 660 feet.
County Barber

Lease Name Mott Ranch Well# 17

Domestic well within 330 feet: yes no

Municipal well within one mile: yes no

Well Drilled For: Well Class: Type Equipment:
 Oil Swd Infield Mud Rotary
 Gas Inj Pool Ext. Air Rotary
 OWWO Expl Wildcat Cable

Depth to Bottom of fresh water 200 feet

Lowest usable water formation Quaternary Permian

Depth to Bottom of usable water 200 feet

Surface pipe by Alternate: 1 2

Surface pipe to be set 320 feet

Conductor pipe if any required ----- feet

Ground surface elevation 1575 feet MSL

This Authorization Expires 4-25-85

Approved By 10-25-84 *[Signature]*

If OWWO: old well info as follows:

Operator
Well Name
Comp Date Old Total Depth
Projected Total Depth 4450 feet
Projected Formation at TD Mississippian
Expected Producing Formations Mississippian


I certify that we will comply with K.S.A. 55-101, et seq., plus eventually plugging hole to K.S.C. specifications.

Date 10/24/84 Signature of Operator or Agent

Charles R. King Title President
Charles R. King *MHC/W/D/HE 10/25/84*

Must be filed with the K.C.C. five (5) days prior to commencing well
 This card void if drilling not started within six (6) months of date received by K.C.C.

A Regular Section of Land
 1 Mile = 5,280 Ft.

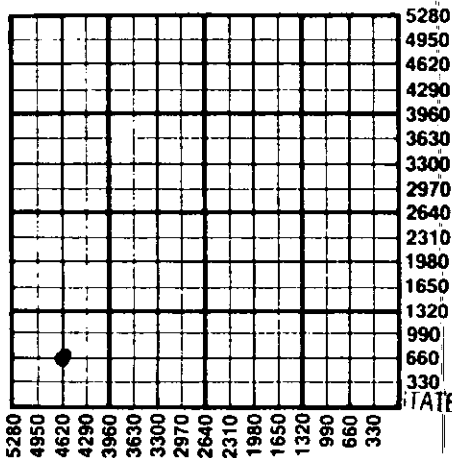

- Important procedures to follow :**
1. Notify District office before setting surface casing.
 2. Set surface casing by circulating cement to the top.
 3. File completion forms ACO-1 with K.C.C. within 90 days of well completion, following instructions on ACO-1, side 1, and including copies of wireline logs.
 4. Notify District office 48 hours prior to old well workover or re-entry.
 5. Prior to plugging, prepare a plugging plan, then obtain agreement from the appropriate district office for an approved plugging plan.
 6. Submit plugging report (CP-4) to K.C.C. after plugging is completed.
 7. Obtain an approved injection docket number before disposing of salt water.
 8. Notify K.C.C. within 10 days when injection commences or terminates.
 9. If an alternate 2 completion, cement in the production pipe from below any usable water to surface within 120 days of spud date.

RECEIVED
 STATE CORPORATION COMMISSION

OCT 25 1994
 10-25-94
 CONSERVATION DIVISION
 Wichita, Kansas

State Corporation Commission of Kansas
 Conservation Division
 200 Colorado Derby Building
 Wichita, Kansas 67202
 (316) 263-3238