

CARD MUST BE TYPED

State of Kansas
NOTICE OF INTENTION TO DRILL
(see rules on reverse side)

CARD MUST BE SIGNED

Starting Date: December 21, 1984
month day year

API Number 15- 007-21,980-00-00

OPERATOR: License # 5435
Name Bowers Drilling Co., Inc.
Address 125 No. Market #1425
City/State/Zip Wichita, Kansas 67202
Contact Person Emil E. Bowers
Phone 316 262-6449

75' S0, CSW-SE.. Sec...4 Twp 31. S, Rge 12. East West
(location)
585 Ft North from Southeast Corner of Section
1980 Ft West from Southeast Corner of Section
(Note: Locate well on Section Plat on reverse side)

CONTRACTOR: License # 5841
Name Trans-Pac Drilling, Inc.
City/State Wichita, Kansas

Nearest lease or unit boundary line 585 feet.
County Barber
Lease Name Olson Well# 1

Well Drilled For: Well Class: Type Equipment:
 Oil Swd Infield Mud Rotary
 Gas Inj Pool Ext. Air Rotary
 OWWO Expl Wildcat Cable

Domestic well within 330 feet: yes no
Municipal well within one mile: yes no

If OWWO: old well info as follows:

Operator
Well Name
Comp Date Old Total Depth
Projected Total Depth 4750' feet
Projected Formation at TD Arbuckle
Expected Producing Formations Douglas, Miss., Simp.

Depth to Bottom of fresh water 200 feet
Lowest usable water formation 200 Top of Penna.
Depth to Bottom of usable water 200 feet
Surface pipe by Alternate: 1 2
Surface pipe to be set 220 feet
Conductor pipe if any required feet
Ground surface elevation 1813 feet MSL
This Authorization Expires 6-18-85
Approved By 12-18-84 R

I certify that we will comply with K.S.A. 55-101, et seq., plus eventually plugging hole to K.C.C. specifications.

Date 12/18/84 Signature of Operator or Agent Emil E. Bowers Title President

President

Form C-1 4/84


MHC/KOHE 12/18/84

Must be filed with the K.C.C. five (5) days prior to commencing well
 This card void if drilling not started within six (6) months of date received by K.C.C.

WICHITA DIVISION
 CONSERVATION
 WICHITA, KANSAS

DEC 1 8 1984

NO. 15180-35330-1
 RECEIVED
 DIVISION OF CONSERVATION
 WICHITA, KANSAS
 DEC 1 1984

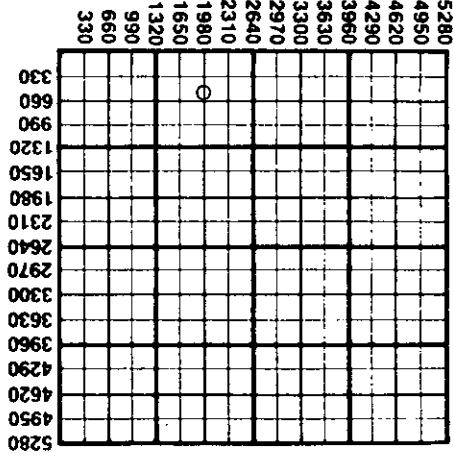

Important procedures to follow:

1. Notify District office before setting surface casing.
2. Set surface casing by circulating cement to the top.
3. File completion forms ACO-1 with K.C.C. within 90 days of well completion, following instructions on ACO-1, side 1, and including copies of wireline logs.
4. Notify District office 48 hours prior to old well workover or re-entry.
5. Prior to plugging, prepare a plugging plan, then obtain agreement from the appropriate district office for an approved plugging plan.
6. Submit plugging report (CP-4) to K.C.C. after plugging is completed.
7. Obtain an approved injection docket number before disposing of salt water.
8. Notify K.C.C. within 10 days when injection commences or terminates.
9. If an alternate 2 completion, cement in the production pipe from below any usable water to surface within 120 days of spud date.

State Corporation Commission of Kansas
 Conservation Division
 200 Colorado Derby Building
 Wichita, Kansas 67202
 (316) 263-3238