

EFFECTIVE DATE: 3-6-91

FORM MUST BE TYPED
FORM C-1 4/90

State of Kansas
NOTICE OF INTENTION TO DRILL

FORM MUST BE SIGNED
ALL BLANKS MUST BE FILLED

Must be approved by the K.C.C. five (5) days prior to commencing well

Expected Spud Date ... March 1 1991
month day year
..NE..SW..NW. Sec ..8.. Twp 31S. S, Rg 12. X East West

OPERATOR: License # 30217
Name: Robba Exploration, Inc.
Address: 230 N. Market
City/State/Zip: Wichita, Kansas 67202
Contact Person: Richard A. Robba
Phone: 316-264-6653

..... 3630 feet from South line of Section
..... 4290 feet from East line of Section
(Note: Locate well on Section Plat on Reverse Side)

CONTRACTOR: License #: 5418
Name: Allen Drilling Company

County: Barber
Lease Name: Gress Well #: 6
Field Name: Nurse
Is this a Prorated Field? yes X no
Target Formation(s): Douglas, Mississippi
Nearest lease or unit boundary: 330'
Ground Surface Elevation: 1720 feet MSL
Domestic well within 330 feet: yes X no
Municipal well within one mile: yes X no
Depth to bottom of fresh water: 180-25
Depth to bottom of usable water: 180
Surface Pipe by Alternate: X 1 2
Length of Surface Pipe Planned to be set: 250
Length of Conductor pipe required: None
Projected Total Depth: 4650
Formation at Total Depth: Simpson
Water Source for Drilling Operations:
... well farm pond X other

Well Drilled For: Well Class: Type Equipment:
X Oil ... Inj X Infield X Mud Rotary
X Gas ... Storage ... Pool Ext. ... Air Rotary
... OWWO ... Disposal ... Wildcat ... Cable
... Seismic; ... # of Holes

If OWWO: old well information as follows:
Operator: NA
Well Name: _____
Comp. Date: _____ Old Total Depth _____

DWR Permit #: to be provided by contractor
Will Cores Be Taken?: yes X no
If yes, proposed zone: _____

Directional, Deviated or Horizontal wellbore? yes No
If yes, total depth location: _____

Docket # 25,939

AFFIDAVIT

The undersigned hereby affirms that the drilling, completion and eventual plugging of this well will comply with K.S.A. 55-101, et. seq.

It is agreed that the following minimum requirements will be met:

1. The appropriate district office shall be notified before setting surface pipe;
2. The minimum amount of surface pipe as specified above shall be set by circulating cement to the top; in all cases surface pipe shall be set through all unconsolidated materials plus a minimum of 20 feet into the underlying formation;
3. If the well is dry, a plugging proposal shall be submitted to the district office. An agreement between the operator and the district office on plug length and placement is necessary prior to plugging;
4. The appropriate district office will be notified before well is either plugged or production casing is cemented in;
5. If an Alternate II completion, production pipe shall be cemented from below any usable water to surface within 120 days of spud date. In all cases, notify district office prior to any cementing.

I hereby certify that the statements made herein are true and to the best of my knowledge and belief.

Date: 2/14/91 Signature of Operator or Agent: Richard A. Robba Title: Geologist

WALTON

FOR KCC USE:

API # 15- 007-22356-00-00
 Conductor pipe required None feet
 Minimum surface pipe required 200 feet per Alt. 100
 Approved by: MAW 3-6-91
 EFFECTIVE DATE: 3-6-91
 This authorization expires: 9-1-91
 (This authorization void if drilling not started within 6 months of effective date.)
 Spud date: _____ Agent: _____

RECEIVED
CORPORATION OF...
FEB 14 1991
CONSERVATION
Wichita, Kansas

8
31
12W

OK by J.C.

REMEMBER TO:

- File Drill Pit Application (form CDP-1) with Intent to Drill;
- File Completion Form ACO-1 within 120 days of spud date;
- File acreage attribution plat according to field proration orders;
- Notify appropriate district office 48 hours prior to workover or re-entry;
- Submit plugging report (CP-4) after plugging is completed;
- Obtain written approval before disposing or injecting salt water.

PLAT OF ACREAGE ATTRIBUTABLE TO A WELL


State Corporation Commission, Conservation Division
200 Colorado Derby Bldg. Wichita, Kansas 67202

OPERATOR Robba Exploration, Inc. LOCATION OF WELL:
LEASE Gress 3630 feet north of SE corner
WELL NUMBER 6 4290 feet west of SE corner
FIELD Nurse Sec. 8 T 31s R 12 E/W
COUNTY Barber

NO. OF ACRES ATTRIBUTABLE TO WELL 160 IS SECTION x REGULAR IRREGULAR?
E/2. & SW/4 of nw/4 sec8 & NE/4NE/4 sec7 IF IRREGULAR, LOCATE WELL FROM NEAREST
DESCRIPTION OF ACREAGE all in 31s-12w CORNER BOUNDARY.

NOTE: If plat depicted is insufficient for your circumstances, you may attach your own scaled or surveyed plat.

PLAT

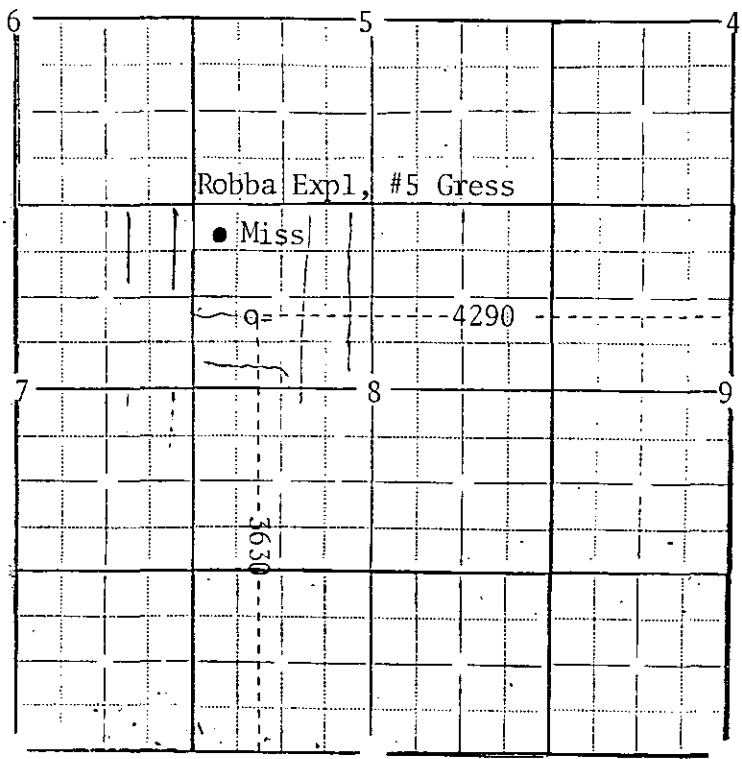

In plotting the proposed location of the well, you must show:

- 1) The manner in which you are using the depicted plat by identifying section lines, i.e. 1 section, 1 section with 8 surrounding partial sections, 4 sections, 16 sections, etc.;
- 2) the well's location relative to the location of other wells producing from the same common source of supply in adjoining drilling units, pursuant to K.A.R. 82-3-108, 82-3-207, 82-3-312, or special orders of the Commission;
- 3) the distance of the proposed drilling location from the section's east and south lines; and
- 4) the distance to the nearest lease or unit boundary line.

I hereby certify that the statements made herein are true and to the best of my knowledge and belief.

Signature of Operator or Agent Richard A. Robba
Date 2/14/91 Title Geologist

Handwritten initials and scribbles, possibly 'JAE' and '41'.