

NOTICE OF INTENTION TO DRILL

(see rules on reverse side)

CORRECTION

CORRECTION

3-27-87

Expected Spud Date..... March 27, 1987  
month day year

API Number 15— 077-21,151-00-00

OPERATOR: License # 5171  
Name TXO Production Corp.  
Address 155 N. Market, Suite 1000  
City/State/Zip Wichita, Kansas 67202  
Contact Person Cory West  
Phone (316) 269-7655

S/2 S/2 NE Sec. 5 Twp. 35 S. Rg. 6  East  West  
\*3035' FSL Ft. from South Line of Section  
\*1100' FEL Ft. from East Line of Section

(Note: Locate well on Section Plat on reverse side)

CONTRACTOR: License # 5107  
Name H-30 Inc.  
City/State Wichita, Kansas

\*Nearest lease or unit boundary line 1100' feet  
County Harper  
Lease Name TAGUE Well # 1  
Ground surface elevation 1312' feet MSL  
Domestic well within 330 feet: —yes  no  
Municipal well within one mile: —yes  no  
Depth to bottom of fresh water 50'  
Depth to bottom of usable water 225'  
Surface pipe by Alternate: 1  2  
Surface pipe planned to be set 250'  
Conductor pipe required 0  
Projected Total Depth 4100' feet  
Formation Stalnaker

Well Drilled For: Well Class: Type Equipment:  
— Oil — Storage  Infield  Mud Rotary  
 Gas — Inj.  Pool Ext. — Air Rotary  
— OWWO — Expl — Wildcat — Cable

If OWWO: old well info as follows:

Operator  
Well Name  
Comp Date Old Total Depth

I certify that well will comply with K.S.A. 55-101, et seq., plus eventually plugging hole to KCC specifications.

Date 3-27-87 Signature of Operator or Agent Cory West Title Drlg. & Prod. Engr.

For KCC Use:

Conductor Pipe Required \_\_\_\_\_ feet; Minimum Surface Pipe Required \_\_\_\_\_ feet per Alt. ①  
This Authorization Expires 9-26-87 Approved By 3-26-87


\*WQS: 2970 FSL 330 N.L. Line  
1320 FEL

Must be filed with the K.C.C. five (5) days prior to commencing well  
This card void if drilling not started within six (6) months of date received by K.C.C.

**Important procedures to follow:**

1. Notify District office before setting surface casing.
2. Set surface casing by circulating cement to the top.
3. File completion forms ACO-1 with K.C.C. within 120 days of well spud date, following instructions on ACO-1, side 1, and including copies of wireline logs.
4. Notify District office 48 hours prior to old well workover or re-entry.
5. Prior to filing Intent, prepare a proposed plugging plan in case well is D & A, then obtain approval of plan when calling district office prior to setting surface pipe.
6. Submit plugging report (CP-4) to K. C. C. after plugging is completed.
7. Obtain an approved injection docket number before disposing of salt water.
8. Notify K.C.C. within 10 days when injection commences or terminates.
9. If an alternate 2 completion, cement in the production pipe from below any usable water to surface within 120 days of spud date.

**A Regular Section of Land  
1 Mile = 5,280 Ft.**

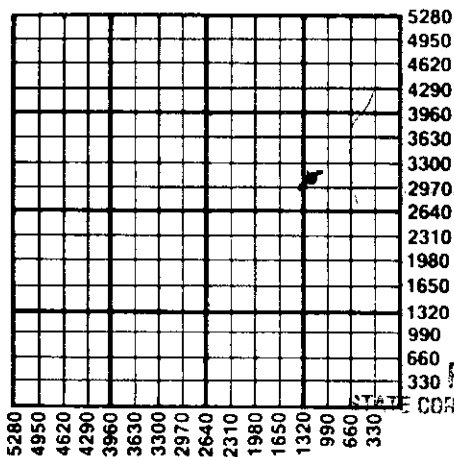

RECEIVED

STATE CORPORATION COMMISSION

MAR 27 1987

CONSERVATION DIVISION  
Wichita, Kansas

State Corporation Commission of Kansas  
Conservation Division  
200 Colorado Derby Building  
Wichita, Kansas 67202-1212  
(316) 263-3238