

CARD MUST BE TYPED

State of Kansas  
**NOTICE OF INTENTION TO DRILL**  
(see rules on reverse side)

CARD MUST BE SIGNED

Starting Date: October 8 1984  
month day year

API Number 15- 007-21,937-0000

OPERATOR: License # 5050

NW.. SW.. SE. Sec 14. Twp. 32 S, Rge. ... 11  East  
(location)  West

Name Hummon Corporation

Address 400 One Main Place

City/State/Zip Wichita, KS 67202

Contact Person Wilber Berg

Phone 263-8521

990..... Ft North from Southeast Corner of Section

2310..... Ft West from Southeast Corner of Section

(Note: Locate well on Section Plat on reverse side)

CONTRACTOR: License # 5148

Name Big-H Drilling, Inc.

City/State Wichita, KS 67202

Nearest lease or unit boundary line 990..... feet.

County Barber

Lease Name Hrencher Well# 3

Domestic well within 330 feet:  yes  no

Municipal well within one mile:  yes  no

Well Drilled For: Well Class: Type Equipment:

Oil  Swd  Infield  Mud Rotary

Gas  Inj  Pool Ext.  Air Rotary

OWWO  Expl  Wildcat  Cable

If OWWO: old well info as follows:

Operator .....

Well Name .....

Comp Date ..... Old Total Depth .....

Projected Total Depth 3900..... feet

Projected Formation at TD Lansing.....

Expected Producing Formations .....

Depth to Bottom of fresh water 100..... feet

Lowest usable water formation Salt Plain Slt.....

Depth to Bottom of usable water 200..... feet

Surface pipe by Alternate: 1  2

Surface pipe to be set 200..... feet

Conductor pipe if any required .....

Ground surface elevation .....

This Authorization Expires 3-28-85

Approved By 9-28-84 *RC*

I certify that we will comply with K.S.A. 55-101, et seq., plus eventually plugging hole to K.C.C. specifications.


Date 9-27-84 Signature of Operator or Agent

*Kenneth S. White* Title Agent

*MHC/MOHE 9/28/84*

Must be filed with the K.C.C. five (5) days prior to commencing well  
This card void if drilling not started within six (6) months of date received by K.C.C.

A Regular Section of Land  
1 Mile = 5,280 Ft.

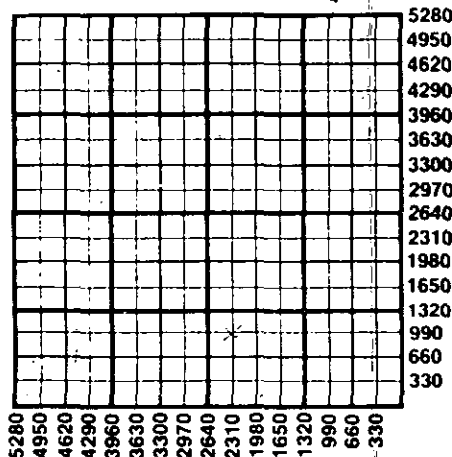

**Important procedures to follow :**

1. Notify District office before setting surface casing.
  2. Set surface casing by circulating cement to the top.
  3. File completion forms ACO-1 with K.C.C. within 90 days of well completion, following instructions on ACO-1, side 1, and including copies of wireline logs.
  4. Notify District office 48 hours prior to old well workover or re-entry.
  5. Prior to plugging, prepare a plugging plan, then obtain agreement from the appropriate district office for an approved plugging plan.
  6. Submit plugging report (CP-4) to K.C.C. after plugging is completed.
  7. Obtain an approved injection docket number before disposing of salt water.
  8. Notify K.C.C. within 10 days when injection commences or terminates.
9. If an alternate 2 completion, cement in the production pipe from below any usable water to surface within 120 days of spud date.

RECEIVED  
STATE CORPORATION COMMISSION

SEP 28 1984  
9-28-84  
State Corporation Commission of Kansas  
Conservation Division  
200 Colorado Derby Building  
Wichita, Kansas 67202  
(316) 263-3238