

revised due to location change

Collection
CARD MUST BE SIGNED
5/6/85

CARD MUST BE TYPED

State of Kansas
NOTICE OF INTENTION TO DRILL
(see rules on reverse side)

CARD MUST BE SIGNED

Starting Date: May 15, 1985
month day year

API Number 15- 077-21,088-00-00

OPERATOR: License # 5230
Name Petroleum Energy, Inc.
Address 224 E. Douglas - Suite 350
City/State/Zip Wichita, Kansas 67202
Contact Person Erin Marshall
Phone 265-2661

* SW.. SE.. NE.. Sec. 16. Twp 35S. S, Rge 5W..
(location)
..2970..... Ft North from Southeast Corner of Section
* ..990..... Ft West from Southeast Corner of Section
(Note: Locate well on Section Plat on reverse side)

CONTRACTOR: License # 5381
Name Big Springs Drilling
City/State Wichita, Kansas 67202

Nearest lease or unit boundary line 330..... feet.
County Harper
Lease Name C. D. WILLIAMS, JR. Well# 'C' #1
Domestic well within 330 feet : yes no
Municipal well within one mile : yes no

Well Drilled For: Well Class: Type Equipment:
 Oil Swd Infield Mud Rotary
 Gas Inj Pool Ext. Air Rotary
 OWWO Expl Wildcat Cable

Depth to Bottom of fresh water 50..... feet
Lowest usable water formation Ninnescaha
Depth to Bottom of usable water 200..... feet
Surface pipe by Alternate : 1 2
Surface pipe to be set 580'..... feet
Conductor pipe if any required feet
Ground surface elevation feet MSL
This Authorization Expires 10-24-85
Approved By 4-29-85

If OWWO: old well info as follows:
Operator
Well Name
Comp Date Old Total Depth
Projected Total Depth 5,275..... feet
Projected Formation at TD Mississippi
Expected Producing Formations Mississippi

I certify that we will comply with K.S.A. 55-101, et seq., plus eventually plugging hole to K.C.C. specifications. SESENE 530FEL


Date 5-6-85..... Signature of Operator or Agent Erin Marshall Title Secretary.....

CONSERVATION DIVISION
Wichita, Kansas

**Must be filed with the K.C.C. five (5) days prior to commencing well
This card void if drilling not started within six (6) months of date received by K.C.C.**

MAY 6 1985

STATE CORPORATION COMMISSION
A Regular Section of Land
1 Mile \times 1/2 Mile

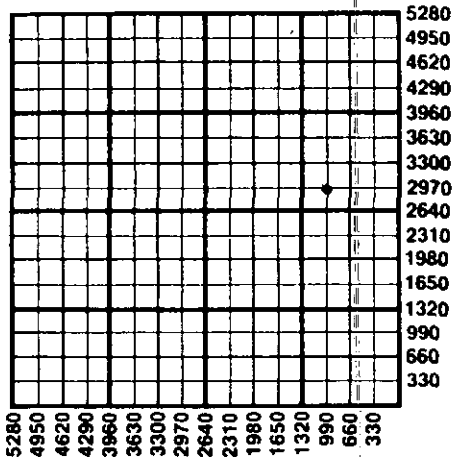

Important procedures to follow :

1. Notify District office before setting surface casing.
2. Set surface casing by circulating cement to the top.
3. File completion forms ACO-1 with K.C.C. within 90 days of well completion, following instructions on ACO-1, side 1, and including copies of wireline logs.
4. Notify District office 48 hours prior to old well workover or re-entry.
5. Prior to plugging, prepare a plugging plan, then obtain agreement from the appropriate district office for an approved plugging plan.
6. Submit plugging report (CP-4) to K.C.C. after plugging is completed.
7. Obtain an approved injection docket number before disposing of salt water.
8. Notify K.C.C. within 10 days when injection commences or terminates.
9. If an alternate 2 completion, cement in the production pipe from below any usable water to surface within 120 days of spud date.

State Corporation Commission of Kansas
Conservation Division
200 Colorado Derby Building
Wichita, Kansas 67202
(316) 263-3238