

STATE CORPORATION COMMISSION OF KANSAS
OIL & GAS CONSERVATION DIVISION

WELL COMPLETION OR RECOMPLETION FORM
ACO-1 WELL HISTORY

DESCRIPTION OF WELL AND LEASE

Operator: License # 5050
Name Hummon Corporation
Address 400 One Main Place
City/State/Zip Wichita, KS 67202

Purchaser NONE

Operator Contact Person Wilber Berg
Phone 263-8521

Contractor: License # 5148
Name Rig-H Drilling, Inc.

Wellsite Geologist Dave Goldak
Phone 263-8521

Designate Type of Completion
 New Well Re-Entry Workover
 Oil SWD Temp Abd
 Gas Inj Delayed Completion
 Dry Other (Core, Water Supply, etc.)

If OWWO: old well info as follows:
Operator
Well Name
Comp. Date Old Total Depth


WELL HISTORY

Drilling Method:
 Mud Rotary Air Rotary Cable
10/9/84 10/16/84 10/17/84
Spud Date Date Reached TD Completion Date
3767' 3443'
Total Depth PBDT

Amount of Surface Pipe Set and Cemented at 208' feet
Multiple Stage Cementing Collar Used? Yes No
If yes, show depth set...feet
If alternate 2 completion, cement circulated from...feet depth to...w/...SX cmt

API NO. 15-007-21,937
County Barber
NW SW SE Sec. 14 Twp. 32 Rge. 11 East West
990 Ft North from Southeast Corner of Section
2310 Ft West from Southeast Corner of Section
(Note: Locate well in section plat below)
Lease Name Hrencher Well # 3
Field Name McGuire Goeman
Producing Formation NONE
Elevation: Ground 1514 KB 1527

Section Plat

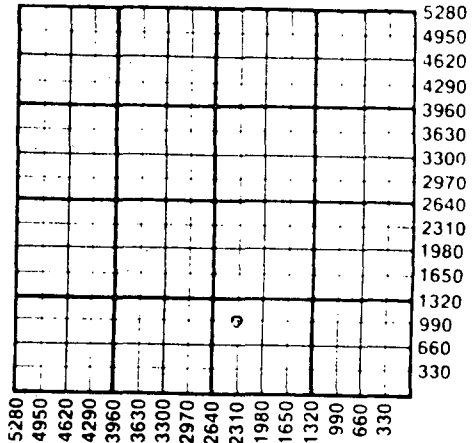

WATER SUPPLY INFORMATION

Disposition of Produced Water: Disposal Repressuring
Docket # NONE

Questions on this portion of the ACO-1 call:
Water Resources Board (913) 296-3717

Source of Water:
Division of Water Resources Permit #
 Groundwater...Ft North from Southeast Corner (Well) ...Ft West from Southeast Corner of Sec Twp Rge East West
 Surface Water...Ft North from Southeast Corner (Stream, pond etc)...Ft West from Southeast Corner Sec Twp Rge East West
 Other (explain) J & M Water Service (purchased from city, R.W.D. #)

INSTRUCTIONS: This form shall be completed in duplicate and filed with the Kansas Corporation Commission, 200 Colorado Derby Building, Wichita, Kansas 67202, within 90 days after completion or recompletion of any well. Rule 82-3-130 and 82-3-107 apply.
Information on side two of this form will be held confidential for a period of 12 months if requested in writing and submitted with the form. See rule 82-3-107 for confidentiality in excess of 12 months.
One copy of all wireline logs and drillers time log shall be attached with this form. Submit CP-4 form with all plugged wells. Submit CP-111 form with all temporarily abandoned wells.

All requirements of the statutes, rules and regulations promulgated to regulate the oil and gas industry have been fully complied with and the statements herein are complete and correct to the best of my knowledge.

Signature Wilber D. Berg
Title Production Manager Date 11/28/84

Subscribed and sworn to before me this 28th day of November 1984
Notary Public Sandra L. Mendoza
Date Commission Expires February 13, 1986

K.C.C. OFFICE USE ONLY
 Letter of Confidentiality Attached
 Wireline Log Received
 Drillers Timelog Received
Distribution
 KCC SWD/Rep NGPA
 KGS Plug Other (Specify)

SANDRA L. MENDOZA
STATE NOTARY PUBLIC
SEDGWICK COUNTY, KANSAS
MY APPT. EXP.

Section 11-30-84

Operator Name Hummon Corporation Lease Name Hrencher Well # 3

Sec. 14 Twp. 32S Rge. 11 East West County Barber

WELL LOG

INSTRUCTIONS: Show important tops and base of formations penetrated. Detail all cores. Report all drill stem tests giving interval tested, time tool open and closed, flowing and shut-in pressures, whether shut-in pressure reached static level, hydrostatic pressures, bottom hole temperature, fluid recovery, and flow rates if gas to surface during test. Attach extra sheet if more space is needed. Attach copy of log.

Drill Stem Tests Taken Yes No
 Samples Sent to Geological Survey Yes No
 Cores Taken Yes No

Formation Description
 Log Sample

DST #1: 2548-2575' OP 20-60-90-60
 GTS 55" into 2ndOP, ga. 5,050 CFG stab., tool slid 10' to bottom, IFP 84-140, FFP 70-42, SIP 997-983, HP 1275-1373, Rec. 60' GCM

DST #2: 3564-3604' OP 45-60-70-90 GTS 25" into 2ndOP, ga. 14,100 CFG, tool slid 10' to bottom, 10" ga. 14,700 CFG, 45 min. ga. 26,600 CFG, Rec. 660' water. SIP 772-758, FP 196-168/210-224, HP 1888-1888

DST #3: 3610-3630' Mis-run, slid tool 30' to bottom, tool plugged.

DST #4: 3610-3630' OP 30-60-30-60 Tool slid 2-3' to bottom, no blow, rec. 480' OCGM, 60' HOCGM, SIP 1211-739 HP 322-322/322-295, HP 1888-1880

DST #5: 3610-3642' OP 45-60-45-90 FP 67-67/80-120 Rec. 90'SOGCM, 60' HO&GCM, SIP 268-376, HP 1821-1821

Name	Top	Bottom
Onaga Sh.	2560	-1033
Wab.	2617	-1090
Tarkio Lm	2774	-1247
Elgin Sh.	3380	-1853
Heebner	3568	-2041
Dgls Lm	3612	-2085
Dgls Sh	3646	-2119
Lans	3751	-2224
LTD	3766	-2239

RELEASED

FEB 07 1986

FROM CONFIDENTIAL

CASING RECORD <input checked="" type="checkbox"/> New <input type="checkbox"/> Used							
Report all strings set-conductor, surface, intermediate, production, etc.							
Purpose of String	Size Hole Drilled	Size Casing Set (in O.D.)	Weight Lbs/Ft.	Setting Depth	Type of Cement	#Sacks Used	Type and Percent Additives
Surface	12-1/4	8-5/8	23#	208	Common	175	2% gel, 3% cc.
Production	7-7/8	4-1/2	9.5 & 10.5	3695	60-40 Poz	125	10% salt, 3/4 cfl% D31.5# gils per #flow-fill/ex.
PERFORATION RECORD				Acid, Fracture, Shot, Cement Squeeze Record			
Shots Per Foot	Specify Footage of Each Interval Perforated			(Amount and Kind of Material Used)		Depth	
4 shots/ft	3612 - 3616			500 gals 15% MCA mud acid		3612-16	
4 shots/ft	2583 - 2586			500 gals gell formation wtr.		3612-16	
				3000 MOD-202, 1500 gell wtr.			
				2000 gals 15% CRA			
				250 gals 15% FE acid		2583-86	
TUBING RECORD				foam-frac w/2000# 20/40 sd			
NONE				2583-86			
Date of First Production	Producing Method						
P & A after completion.	<input type="checkbox"/> Flowing <input type="checkbox"/> Pumping <input type="checkbox"/> Gas Lift <input type="checkbox"/> Other (explain).....						
Estimated Production Per 24 Hours	Oil	Gas	Water	Gas-Oil Ratio	Gravity		
	Bbls	MCF	Bbls	CFPB			

METHOD OF COMPLETION

Production Interval

Disposition of gas: Vented Open Hole Perforation
 Sold Other (Specify)
 Used on Lease Dually Completed
 Commingled