

This form shall be filed in duplicate with the Kansas Corporation Commission, 200 Colorado Derby Building, Wichita, Kansas 67202, within ten days after the completion of the well, regardless of how the well was completed.

Attach separate letter of request if the information is to be held confidential. If confidential, only file one copy. Information on side one will be of public record and side two will then be held confidential.

Circle one: Oil, Gas, Dry SWD, OWWO, Injection. Type and complete ALL sections. Applications must be filed for dual completion, commingling, SWD and injection, T.A.

Attach wireline logs (i.e. electrical log, sonic log, gamma ray neutron log, etc.). KCC # (316) 263-3238. (Rules 82-2-105 & 82-2-125)

OPERATOR ROBINSON OIL COMPANY

API NO. 15-007-20763-00-00

ADDRESS 737 R. H. Garvey Building
Wichita, Kansas 67202

COUNTY Harper
FIELD Wildcat

**CONTACT PERSON Dale M. Robinson
PHONE 262-6734

PROD. FORMATION - -
LEASE CINK "A"

PURCHASER No Production

WELL NO. 1

ADDRESS N/A


WELL LOCATION 225' SW of C NW SW

DRILLING CONTRACTOR TRANS-PAC DRILLING, INC
ADDRESS 600 One Main Place
Wichita, KS. 67202

1760 Ft. from S Line and
510 Ft. from W Line of
the SW/4 SEC. 8 TWP. 35S RGE. 5W

PLUGGING CONTRACTOR TRANS-PAC DRILLING, INC.
ADDRESS 600 One Main Place
Wichita, KS 67202

WELL PLAT

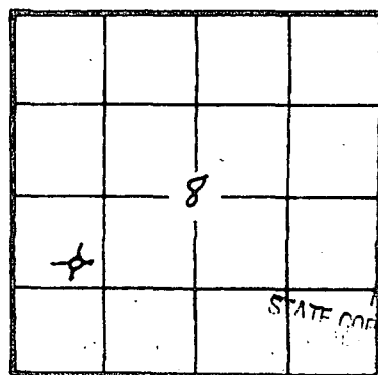

KCC
KGS
(Office Use)

RECEIVED
STATE CORPORATION COMMISSION
JAN 14 1982
Wichita, Kansas

TOTAL DEPTH 4772 PBD 4772

SPUD DATE 12/16/81 DATE COMPLETED 12/30/81

ELEV: GR 1236 DF 1241 KB 1244

DRILLED WITH (CABLE) (ROTARY) (AIR) TOOLS

Amount of surface pipe set and cemented 264

DV Tool Usage

AFFIDAVIT

STATE OF KANSAS, COUNTY OF SEDGWICK SS, I,

BRUCE M. ROBINSON OF LAWFUL AGE, BEING FIRST DULY SWORN UPON HIS OATH,

DEPOSES THAT HE IS Agent (FOR)(X) Robinson Oil Company

OPERATOR OF THE Cink "A" LEASE, AND IS DULY AUTHORIZED TO MAKE

THIS AFFIDAVIT FOR AND ON THE BEHALF OF SAID OPERATOR, THAT WELL NO. 1 ON

SAID LEASE HAS BEEN COMPLETED AS OF THE 30th DAY OF December, 19 81, AND THAT

ALL INFORMATION ENTERED HEREIN WITH RESPECT TO SAID WELL IS TRUE AND CORRECT.

FURTHER AFFIANT SAITH NOT.

SUBSCRIBED AND SWORN BEFORE ME THIS 7th DAY OF January, 19 82

(S) Bruce M. Robinson
Barbara E. Lewis
NOTARY PUBLIC

MY COMMISSION EXPIRES:

BARBARA E. LEWIS
NOTARY PUBLIC
My Appt. Exp. 4-17-85

**The person who can be reached by phone regarding any questions concerning this information. Within 45 days of completion, a witnessed initial test by the Commission is required if the well produces more than 25 BOPD or is located in a Basic Order Pool.