


STATE OF KANSAS
STATE CORPORATION COMMISSION

WELL PLUGGING RECORD

Give All Information Completely
Make Required Affidavit
Mail or Deliver Report to
Conservation Division
State Corporation Comm.
245 North Water
Wichita, KS 67202

Barber County. Sec. 2 Twp. 30S Rge. 11W E/W
Location as "NE/CNW $\frac{1}{4}$ /SW $\frac{1}{4}$ " or footage from lines _____
C - NW
Lease Owner Bessie Kruchenberg
Lease Name Harding #2 Well No. _____
Office Address R R #1, Isabel, Ks. 67065
Character of Well (Completed as Oil, Gas or Dry Hole) _____

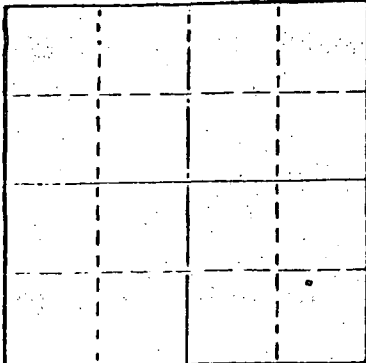

Locate well correctly on above
Section Plat

Date Well completed _____ 19____
Application for plugging filed _____ 19____
Application for plugging approved _____ 19____
Plugging commenced 2/11/81 _____ 19____
Plugging completed 2/18/81 _____ 19____
Reason for abandonment of well or producing formation _____
Depleted
If a producing well is abandoned, date of last production _____
Wichita, Kansas 19____

Was permission obtained from the Conservation Division or
its agents before plugging was commenced? Yes

Name of Conservation Agent who supervised plugging of this well Maurice Leslie
Producing formation _____ Depth to top _____ Bottom _____ Total Depth of Well 2939
Show depth and thickness of all water, oil and gas formations.

OIL, GAS OR WATER RECORDS

CASING RECORD

FORMATION	CONTENT	FROM	TO	SIZE	PUT IN	PULLED OUT
				8-5/8"	200	None
				4-1/2"	2935	1169'

Describe in detail the manner in which the well was plugged, indicating where the mud fluid was placed and the method or methods used in introducing it into the hold. If cement or other plugs were used, state the character of same and depth placed, from _____ feet to _____ feet for each plug set.

Made bottom hole plug back with sand to 2675. ~~RAN~~ Ran 4 sacks cement. Made shot at 2610. Pulled total of 29 joints. Squeezed hole with 15 sacks gel, 6 sacks hulls and 10 sacks gel. Released plug and displaced with 100 sacks 50/50 pos, 4% gel, 3% cc. Plugging complete.

RECEIVED
STATE CORPORATION COMMISSION

FEB 24 1981

(If additional description is necessary, use BACK of this sheet)


Name of Plugging Contractor KELSO CASING PULLING
CHASE, KANSAS
Conservation Division
Wichita, Kansas

STATE OF Kansas COUNTY OF Rice, ss.
R. Darrell Kelso (employee of owner) or (owner or operator)
of the above-described well, being first duly sworn on oath, says: That I have knowledge of the facts, statements, and matters herein contained and the log of the above-described well as filed and that the same are true and correct. So help me God.

(Signature) R. Darrell Kelso
Chase, Kansas (Address)

SUBSCRIBED AND SWORN TO before me this 23rd day of February, 19 81

My commission expires

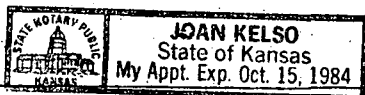

Joan Kelso
Notary Public.

DRILLERS LOG

HARDING No. 2

CASING RECORD:

200' of 8 5/8"
w/225 sx. cmt.
2863' of 4 1/2" casing
w/100 Sx.

COMPANY: Kruckenbug-Scott.

CONTRACTOR: Blue Streak Drlg. Inc.

COMMENCED: Dec. 2, 1977

COMPLETED: Dec. 7, 1977

DESCRIPTION:

C NW -Sec. 2-30S-11 W
Barber Co., Ks.

TOTAL DEPTH:

ELEVATION:

<u>FORMATION</u>	<u>FROM</u>	<u>TO</u>	<u>REMARKS</u>
Shale & lime Streaks	0	1725	
Lime & Shale	1725	2028	
Shale & Lime Stks.	2028	2308	
Lime & Shale	2308	2711	
Sand	2711	2720	
Shale	2720	2740	
Lime & Shale	2740	2935	
Total Depth	2935'		

I certify that this is a true and correct copy of the above log to the best of my knowledge.

BLUE STREAK DRILLING INC

Louis Elster
Louis Elster

Subscribed and sworn to before me this 12th day of December, 1977

Alma Mae Hassler
Notary Public Alma Mae Hassler

My Commission Expires:
12-21-79

RECEIVED
CONSERVATION DIVISION

NOV 20 1980

CONSERVATION DIVISION
Wichita, Kansas

