


STATE OF KANSAS
STATE CORPORATION COMMISSION
200 Colorado Derby Bldg.
Wichita, Kansas 67202

Form CP-4
Rev. 12-15-80

WELL PLUGGING RECORD

Give All Information Completely
Make Required Affidavit

COUNTY Barber SEC. 4 TWP. 30S RGE. 11W XX/W
Location as in quarters or footage from lines:
2060' FNL; 1130' FWL NW/4

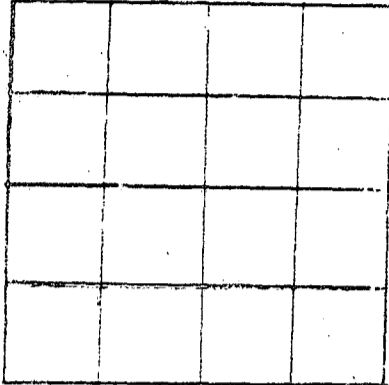

Locate Well
correctly on above
Section Platt.

Lease Owner Kruckenberg & Scott
Lease Name Crawford Well No. 3
Office Address Isabel, Kansas 67065
Character of Well (Completed as Oil, Gas or Dry Hole): Dry Hole
Date Well Completed June 14, 1982
Application for plugging filed June 14, 1982
Plugging commenced June 14, 1982
Plugging completed June 14, 1982

Reason for abandonment of well or producing formation D & A

Was permission obtained from the Conservation Division or it's Agent's before plugging was commenced? Yes

Name of Conservation Agent who supervised plugging of this well Maurice V. Leslie

Producing formation _____ Depth to top _____ bottom T.D. 2,775'

Show depth and thickness of all water, oil and gas formations.

OIL, GAS OR WATER RECORDS Casing Record

Formation	Content	From	To	Size	Put in	Pulled Out
				8 5/8"	217.55'	-0-

Describe in detail the manner in which the well was plugged, indicating where the mud fluid was placed and the method or methods used in introducing it into the hold. If cement or other plugs were used, state the character of same and depth placed, from _____ feet to _____ feet for each plug set.

Plugged hole @ 600' w/60 sx cement
@ 210' w/40 sx cement
@ 40' w/10 sx cement, hulls & plug
10 sx cement in rathole
50-50 Pozmix, 2% Gel, 3% C.C.

RECEIVED
STATE CORPORATION COMMISSION

SEP 14 1982

CONSERVATION DIVISION
Wichita, Kansas


(If additional description is necessary, use BACK of this sheet.)

Name of Plugging Contractor Red Tiger Drilling Company
1720 KSB Building, Wichita, Kansas 67202

STATE OF Kansas COUNTY OF Barber, ss.
Bessie Kruckenberg (employee of owner) or (owner or operator) of the above-described well, being first duly sworn on oath, says: That I have knowledge of the facts, statements, and matters herein contained and the log of the above-described well as filed and that the same are true and correct. So help me God.

(Signature) Bessie Kruckenberg
(Address) _____

SUBSCRIBED AND SWORN TO before me this 10 day of Sept, 19 82

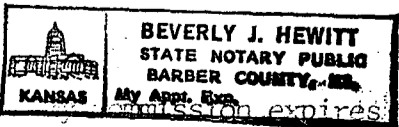

Beverly J. Hewitt
Notary Public.