

STATE OF KANSAS
STATE CORPORATION COMMISSION
200 Colorado Derby Bldg.
Wichita, Kansas 67202

Form CP-4
Rev. 12-15-80

WELL PLUGGING RECORD

Give All Information Completely
Make Required Affidavit

COUNTY Barber SEC. 4 TWP. 30S RGE. 11 E/W

Location as in quarters or footage from lines:

1240' FWL & 2000' FNL NW/4

1530 2/20

Lease Owner Kruckenber & Scott

Lease Name Crawford Well No. 2

Office Address Isabel, Kansas 67205

Character of Well (Completed as Oil, Gas or Dry Hole): D & A


Date Well Completed June 4, 1982

Application for plugging filed June 3, 1982

Plugging commenced June 4, 1982

Plugging completed June 4, 1982

Reason for abandonment of well or producing formation D & A

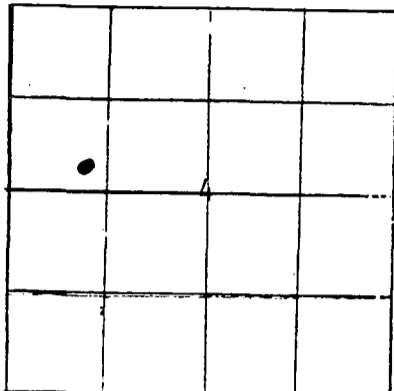

Locate Well
correctly on above
Section Platt.

Was permission obtained from the Conservation Division or it's
Agent's before plugging was commenced? yes

Name of Conservation Agent who supervised plugging of this well Maurice V. Leslie

Producing formation n/a Depth to top n/a bottom n/a T.D. 3777'

Show depth and thickness of all water, oil and gas formations.

OIL, GAS OR WATER RECORDS

Casing Record

Formation	Content	From	To	Size	Put in	Pulled Out
				8 5/8"	208.64	-0-

Describe in detail the manner in which the well was plugged, indicating where the mud fluid was placed and the method or methods used in introducing it into the hold. If cement or other plugs were used, state the character of same and depth placed, from _____ feet to _____ feet for each plug set.

Plugged Hole
60 sx @ 600'
40 sx @ 210'
1/2 sx hull
Plug @ 40' w/10 sx
10 sx in Rat Hole

(If additional description is necessary, use BACK of this sheet)

Name of Plugging Contractor Halliburton, 410 Union Center Bldg., Wichita, Kansas 67202

STATE OF Kansas COUNTY OF Barber, ss.

Bessie Kruckenber (employee of owner) or (owner or operator) of the above-described well, being first duly sworn on oath, says: That I have knowledge of the facts, statements, and matters hereinafter contained and the log of the above-described well as filed and that the same are true and correct. So help me God.


SEP 14 1982

(Signature) Bessie Kruckenber

(Address)

CONSERVATION DIVISION
Wichita, Kansas

SUBSCRIBED AND SWORN TO before me this 10 day of Sept, 1982

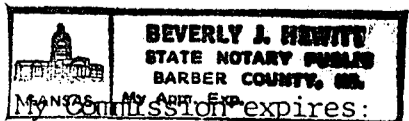

Beverly J. Hewitt
Notary Public.