


STATE OF KANSAS
STATE CORPORATION COMMISSION

WELL PLUGGING RECORD

Give All Information Completely
Make Required Affidavit
Mail or Deliver Report to
Conservation Division
State Corporation Comm.
245 North Water
Wichita, KS 67202

Barber County, Sec. 11 Twp. 30S Rge. 11W E/W
Location as "NE/CNW 1/4 SW 1/4" or footage from lines
1320' FSL 1260' FWL of NW/4
Lease Owner Kruckenberg & Scott
Lease Name Kruckenberg Well No. 1
Office Address c/o Bessie Kruckenberg, Isabel, Kansas 67065
Character of Well (Completed as Oil, Gas or Dry Hole) _____

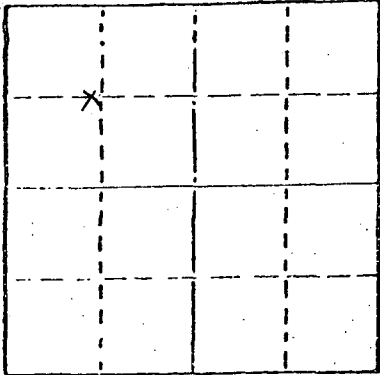

Locate well correctly on above
Section Plat

D & A
Date Well completed August 2, 1977
Application for plugging filed August 2, 1977
Application for plugging approved August 2, 1977
Plugging commenced August 2, 1977
Plugging completed August 2, 1977
Reason for abandonment of well or producing formation
D & A

If a producing well is abandoned, date of last production
19

Was permission obtained from the Conservation Division or
its agents before plugging was commenced? Yes

Name of Conservation Agent who supervised plugging of this well Jasper H. Metz
Producing formation _____ Depth to top _____ Bottom _____ Total Depth of Well 2,951'
Show depth and thickness of all water, oil and gas formations.

OIL, GAS OR WATER RECORDS

CASING RECORD

FORMATION	CONTENT	FROM	TO	SIZE	PUT IN	PULLED OUT
				8 5/8"	174.63'	-0-

Describe in detail the manner in which the well was plugged, indicating where the mud fluid
was placed and the method or methods used in introducing it into the hold. If cement or other
plugs were used, state the character of same and depth placed, from _____ feet to
_____ feet for each plug set.

Plug @ 200' w/35 sx cement
Plug @ 40' w/1/2 sx hulls, 12 sx cement
3 sx cement in rathole

RECEIVED
STATE CORPORATION COMMISSION

OCT 04 1977

CONSERVATION DIVISION
Wichita, Kansas

(If additional description is necessary, use BACK of this sheet)

Name of Plugging Contractor Red Tiger Drilling Company
1720 KSB&T Building, Wichita, Kansas 67202

STATE OF Kansas COUNTY OF Sedgwick, ss. contractor
Gloria Fawcett (employee of xxxxxx)


of the above-described well, being first duly sworn on oath, says: That I have knowledge of
the facts, statements, and matters herein contained and the log of the above-described well
as filed and that the same are true and correct. So help me God.

(Signature) Gloria Fawcett
1720 KSB&T Building, Wichita, Kansas 67202
(Address)

SUBSCRIBED AND SWORN TO before me this 8th day of August, 1977.

Joyce A. Hagermann
Notary Public.

My commission expires _____

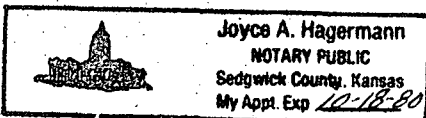

DRILLERS LOG

No. 1 Kruckenberg

CASING RECORD:

COMPANY: Kruckenberg & Scott

DESCRIPTION:

8 5/8" @ 181.63'
w/200-sx cement

CONTRACTOR: Red Tiger Drilling Company

1320' FSL 1260' FWL of NW/4
Sec. 11-T30S-R11W
Barber County, Kansas

COMMENCED: July 28, 1977

COMPLETED: August 2, 1977

TOTAL DEPTH: 2,951'

ELEVATION: 1,803' GR

FORMATION

FROM

TO

REMARKS

Clay	0	58	
Sand	58	160	
Shale	160	185	
Red Bed & Shale	185	725	
Shale	725	1370	
Shale & Lime	1370	1760	
Lime	1760	2410	
Lime & Shale	2410	2700	
Shale & Sand	2700	2750	
Shale & Lime	2750	2780	
Lime & Shale	2780	2951	
RTD		2951	

I certify that this is a true and correct copy of the above log to the best of my knowledge.

RED TIGER DRILLING COMPANY

Gloria Fawcett
Gloria Fawcett

Subscribed and sworn to before me this 8th day of August, 1977.

RECEIVED
CORPORATION COMMISSION
OCT 26 1977
CONSERVATION DIVISION
Wichita, Kansas

Joyce A. Hagermann
Notary Public

