


15-007-01748-0000

STATE OF KANSAS
STATE CORPORATION COMMISSION

WELL PLUGGING RECORD

Give All Information Completely
Make Required Affidavit
Mail or Deliver Report to:
Conservation Division
State Corporation Commission
211 No. Broadway
Wichita, Kansas

Barber County. Sec. 14 Twp. 32 Rge. 11 (E) W (W)
Location as "NE/CNW/SW" or footage from lines NE SW SW
Lease Owner Beardmore Drilling Company
Lease Name Stewart "C" Well No. 3
Office Address 827 Beacon Building, Wichita, Kansas
Character of Well (completed as Oil, Gas or Dry Hole) Dry Hole
Date well completed 10-13 1957
Application for plugging filed 10-13 1957
Application for plugging approved 10-13 1957
Plugging commenced 10-13 1957
Plugging completed 10-13 1957
Reason for abandonment of well or producing formation Dry Hole

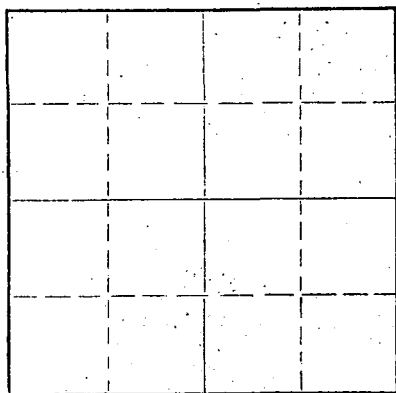

Locate well correctly on above
Section Plat

If a producing well is abandoned, date of last production 19
Was permission obtained from the Conservation Division or its agents before plugging was commenced? Yes

Name of Conservation Agent who supervised plugging of this well M. A. Rives
Producing formation _____ Depth to top _____ Bottom _____ Total Depth of Well _____ Feet
Show depth and thickness of all water, oil and gas formations.

OIL, GAS OR WATER RECORDS

CASING RECORD

FORMATION	CONTENT	FROM	TO	SIZE	PUT IN	PULLED OUT
Soil		0	20			
Sand		20	80			
Shale & Shells		80	214	8-5/8"	214	0

Describe in detail the manner in which the well was plugged, indicating where the mud fluid was placed and the method or methods used in introducing it into the hole. If cement or other plugs were used, state the character of same and depth placed, from _____ feet to _____ feet for each plug set.

0 to 30' - 10 sacks cement


30' - Wood Plug

30' to 140' - Heavy Mud

140' to 200' - 20 sacks cement

200' - Wood Plug

200' to 3633' - Heavy Mud

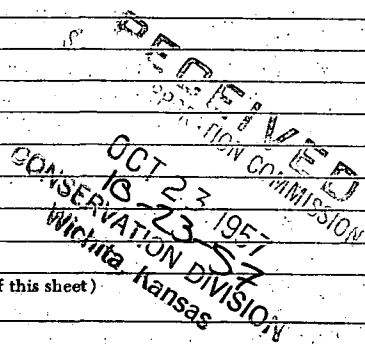

(If additional description is necessary, use BACK of this sheet)


Name of Plugging Contractor Beardmore Drilling Company
Address 827 Beacon Building, Wichita, Kansas

STATE OF KANSAS, COUNTY OF SEDGWICK, ss.
Heber Beardmore (employee of owner) or (owner or operator) of the above-described well, being first duly sworn on oath, says: That I have knowledge of the facts, statements, and matters herein contained and the log of the above-described well as filed and that the same are true and correct. So help me God.

(Signature) Heber Beardmore
827 Beacon Building, Wichita, Kansas
(Address)

SUBSCRIBED AND SWORN TO before me this 18th day of October 19 57
Leonard P. Tolle
Leonard P. Tolle - Notary Public.

My commission expires January 28, 1960

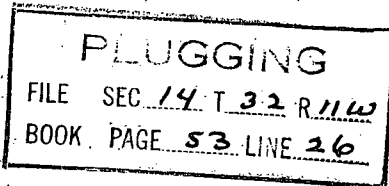

BEARDMORE-BARBARA
 #3 Stewart "C"
 NE SW SW Section 14-32S-11W
 Barber County, Kansas

Drilled By: Beardmore Drilling Company
 Drilling Commenced: 10-4-57
 Drilling Completed: 10-13-57

Casing Record:
 Ran 216' of 8-5/8" set at 214' with 130 sacks. Cement circulated.
 10-4-57.

Elevations: KB 1516
 DF 1514 Est
 Gr 1511

<u>FORMATIONS</u>	<u>DEPTH</u>
Sand	80
Red Bed Shale and Shells	214
Shale and Lime	1325
Shale and Lime	2440
Shale and Lime	3000
Shale and Lime	3230
Shale and Lime	3530
Shale and Lime	3575
Rotary Total Depth	3633

TOPS

Snyderville Sand 3579

CORE #1 3575-3597 Recovered 22'

DST #1 3583-3597 Shut in 20 min., open tool, good blow, gas in 50 min., no gauge, open 1 hr., shut in 20 min. Recovered 100' gas cut mud, 1320' muddy gassy water with oil scum. IBHP 1352, FBHP 915, IF 165, FF 560.

CORE #2 3595-3633. Recovered 38' Sand 3597-3599, Shale 3599-3620, Cherty Limestone with show of heavy black oil 3620-3633.

DST #2 3622-3633 Shut in 20 min., open 1 hr., shut in 20 min., weak blow. Recovered 30' of mud, no flow pressures. IBHP failed, FBHP 180#.

STATE OF KANSAS }
 COUNTY OF SEDGWICK) ss

RECEIVED

I, the undersigned, being duly sworn on oath state that the above and within statement is a true and correct record and log of the well drilled on the location above described, to the best of my knowledge and belief.

BEARDMORE DRILLING COMPANY

By W. H. Beardmore

Subscribed and sworn to before me this 18th day of October, 1957.

Leonard P. Tolle
 Leonard P. Tolle-Notary Public

My Commission Expires:
 January 28, 1960.

PLUGGING
 FILE SEC. 14 T. 32 R. 11W
 BOOK PAGE 53 LINE 26