

15-007-00182-0000


Give All Information Completely
Make Required Affidavit
Mail or Deliver Report to:
Conservation Division
State Corporation Commission
211 No. Broadway
Wichita, Kansas

WELL PLUGGING RECORD

Barber County. Sec. 14 Twp. 32S Rge. 11 ~~xxx~~ W (w)
SW SW SW

Location as "NE/CNW%SW%" or footage from lines.
Lease Owner H. C. Bennett
Lease Name Stewart "C" Well No. 1
Office Address 1212 Union Nat'l Bldg., Wichita, Kansas
Character of Well (completed as Oil, Gas or Dry Hole) oil well
Date well completed 5-29 19 56
Application for plugging filed 1-02 19 64
Application for plugging approved 1-06 19 64
Plugging commenced 1-04 19 64
Plugging completed 1-20 19 64
Reason for abandonment of well or producing formation depleted

NORTH

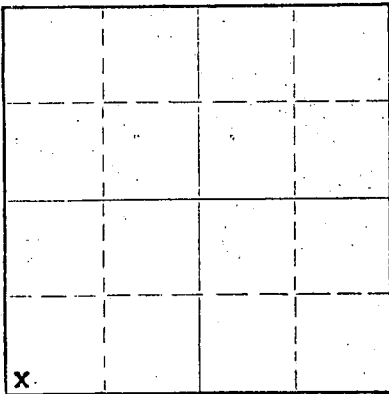

Locate well correctly on above
Section Plat

If a producing well is abandoned, date of last production _____ 19____
Was permission obtained from the Conservation Division or its agents before plugging was commenced? yes

Name of Conservation Agent who supervised plugging of this well Archie Elving
Producing formation _____ Depth to top _____ Bottom _____ Total Depth of Well 3687 Feet
Show depth and thickness of all water, oil and gas formations.

OIL, GAS OR WATER RECORDS

CASING RECORD

FORMATION	CONTENT	FROM	TO	SIZE	PUT IN	PULLED OUT
				8 5/8	183	circulated
				5 1/2	3667	3208.

Describe in detail the manner in which the well was plugged, indicating where the mud fluid was placed and the method or methods used in introducing it into the hole. If cement or other plugs were used, state the character of same and depth placed, from _____ feet to _____ feet for each plug set.

Filled hole with chat from 3587 feet to 3560 feet and dumped 5 sacks cement. Pumped 15 sacks of jell and 80 ~~xxx~~ sacks pf cement down 8 5/8 pipe. Top plug pumped by Halliburton.

RECEIVED
STATE CORPORATION COMMISSION

JAN 29 1964
1-29-64

CONSERVATION DIVISION
Wichita, Kansas

(If additional description is necessary, use BACK of this sheet)
Name of Plugging Contractor Flint Engineering & Construction Co.
Address Box 342, El Dorado, Kansas

STATE OF Kansas COUNTY OF Butler ss.

(employee of owner) or (owner or operator) of the above-described well, being first duly sworn on oath, says: That I have knowledge of the facts, statements, and matters herein contained and the log of the above-described well as filed and that the same are true and correct. So help me God.

(Signature) Mary Payne
El Dorado, Kansas
(Address)

SUBSCRIBED AND SWORN TO before me this 28th day of January, 19 64

My commission expires September 27, 1967

Ronald P. Hanson
Notary Public.



BEARDMORE-BARBARA
 #1 Stewart "C"
 SW SW SW Sec. 14-32S-11W
 Barber County, Kansas

Drilled By: Beardmore Drilling Company
 Drilling Commenced: 5-14-56
 Drilling Completed: 5-29-56

Casing Record:

Ran 188' of 8 5/8" set at 183' with 120 sacks. Cement circulated.
 5-14-56.
 5 1/2" set at 3667' with 75 sacks cement. 5-29-56

Elevations: KB 1513
 DF 1510
 Gr 1508

<u>FORMATIONS</u>	<u>DEPTH</u>
Cellar	5
Sand	80
Red Rock and Shale	183
Shale	955
Salt	1475
Shale and Shells	1555
Shale and Lime	1755
Shale and Lime	2420
Shale and Lime	2965
Shale and Lime	3400
Shale and Lime	3605
Shale and Lime	3830
Lime	3897
Lime	3991
Lime and Shale	4225
Lime and Shale	4400
Lime	4435
Lime and Shale	4520
Lime and Shale	4630
Lime	4710
Lime	4775
Sand	4787
Sand and Shale	4830
Rotary Total Depth	4915
Cable Tool Total Depth	3687

TOPS

Lansing	3741
Ero. Mississippi	4387
Ero. Mississippi Limestone	4432
Kinderhook	4564
Viola	4669
Simpson Shale	4744
Simpson Sand	4760
Arbuckle	4868

DRILL STEM TEST #1 - 3579-3605 Shut in 15 min., open 1 hr., shut in 15 min., gas to surface in 12 min. (40,000 in 15 min. and 80,000 at end of hour). Recovered 30' gas cut mud, 60' gas cut mud with oil specks, 60' heavily oil and gas cut mud, 60' oily mud, 60' muddy oil. IF 100, FF 225, IBHP 1365, FBHP 1370.

STATE OF KANSAS)
) ss
 COUNTY OF SEDGWICK)

I, the undersigned, being duly sworn on oath state that the above and within statement is a true and correct record and log of the well drilled on the location above described, to the best of my knowledge and belief.

Robert J. Tolth

Subscribed and sworn to before me this 15th day of June, 1956.

Leonard P. Tolth

My Commission Expires:
 January 28, 1960

Notary Public

RECEIVED
 STATE CORPORATION COMMISSION
 JAN 29 1964
 1-29-64
 CONSERVATION DIVISION
 Wichita, Kansas